SDP2020-27

MAJOR SITE PLAN AMENDMENT

FOR

29TH PLACE DRIVE THRU

LOCATION OF SITE

1500 SEMINOLE TRAIL
CHARLOTTESVILLE, VA 22901
RIO MAGISTERIAL DISTRICT
ALBEMARLE COUNTY, VIRGINIA
PID: 061U0-01-00-01500

SHEET INDEX

SHEET TITLE	SHEET NUMBER
COVER SHEET	C-100
GENERAL NOTES	C-101
GENERAL NOTES AND LEGEND	C-102
EXISTING CONDITIONS & DEMOLITION PLAN	C-202
SITE PLAN	C-301
SIGHT DISTANCE PROFILES	C-302
GRADING PLAN	C-401
UTILITY PLAN	C-501
LANDSCAPE PLAN	C-601
LANDSCAPE NOTES AND DETAILS	C-602
CONSTRUCTION DETAILS	C-801 - C-802
MAINTENANCE OF TRAFFIC PLAN	C-803

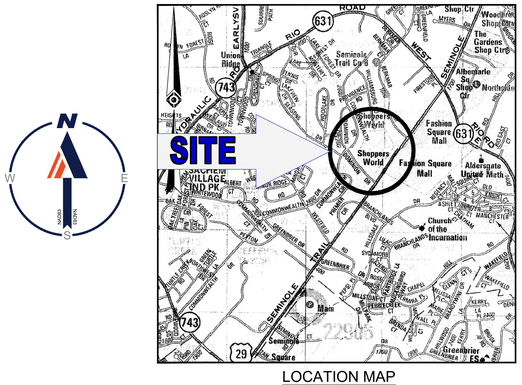

LOCATION MAP

COPYRIGHT ADC THE MAP PEOPLE
PERMIT USE NO. 20602153-5

SCALE: 1"=2000'

DEVELOPER

FEDERAL REALTY INVESTMENT TRUST
1626 E JEFFERSON STREET
ROCKVILLE, MD 20852
CONTACT: CHRISTINE MCGUIRL

OWNER

FEDERAL REALTY INVESTMENT TRUST
1626 E JEFFERSON STREET
ROCKVILLE, MD 20852
CONTACT: CHRISTINE MCGUIRL

PREPARED BY

BOHLER

28 BLACKWELL PARK LANE, SUITE 201
WARRENTON, VIRGINIA 20186
Phone: (540) 349-4500
Fax: (540) 349-0321
VA@BohlerEng.com

CONTACT: RYAN T. YAUGER, P.E.

RYAUGER@BOHLERENG.COM

CONTACT INFORMATION

♦ *REFERENCES*

BOUNDARY & TOPOGRAPHIC/ALTA SURVEY:

"BOUNDARY AND TOPOGRAPHIC SURVEY
FEDERAL REALTY INVESTMENT TRUST
29TH PLACE"
1500-1520 SEMINOLE TRAIL, US RTE. 29
RIO MAGISTERIAL DISTRICT,
ALBEMARLE COUNTY
PREPARED BY: BOHLER
DATED 3/13/2020

♦ *GOVERNING AGENCIES*

COUNTY OF ALBEMARLE
DEPARTMENT OF COMMUNITY DEVELOPMENT
401 McINTIRE ROAD
CHARLOTTESVILLE, VA 22902
PHONE: (434) 296-5832
FAX: (434) 972-4126

♦ *UTILITIES*

ALBEMARLE COUNTY SERVICE AUTHORITY
168 SPOTNAP ROAD
CHARLOTTESVILLE, VA 22911
TEL: (434) 977-4511

APPROVALS	DATE
DEPARTMENT OF COMMUNITY DEVELOPMENT	
PLANNER/ZONING	
ENGINEER	
INSPECTIONS	
ARB	
DEPARTMENT OF FIRE RESCUE	
ALBEMARLE COUNTY SERVICE AUTHORITY	
VIRGINIA DEPARTMENT OF TRANSPORTATION	

BOHLER™
SITE CIVIL AND CONSULTING ENGINEERING
LAND SURVEYING
PROGRAM MANAGEMENT
LANDSCAPE ARCHITECTURE
SUSTAINABLE DESIGN
PERMITTING SERVICES
TRANSPORTATION SERVICES
THE INFORMATION, DESIGN AND CONCEPTS OF THIS PLAN ARE PROPRIETARY AND SHALL NOT BE COPIED OR USED FOR ANY PURPOSE WITHOUT PRIOR WRITTEN AUTHORIZATION FROM BOHLER. ONLY APPROVED PLANS SHALL BE UTILIZED FOR CONSTRUCTION PURPOSES. © BOHLER

REVISIONS

REV	DATE	COMMENT	DRAWN BY / CHECKED BY

811 Know what's below. Call before you dig.
ALWAYS CALL 811
It's fast. It's free. It's the law.

NOT APPROVED FOR CONSTRUCTION

THIS DRAWING IS INTENDED FOR MUNICIPAL AND/OR AGENCY REVIEW AND APPROVAL. IT IS NOT INTENDED AS A CONSTRUCTION DOCUMENT UNLESS INDICATED OTHERWISE.

PROJECT No.: V194600
DRAWN BY: EEN
CHECKED BY: RTY
DATE: 03/18/2020
CAD I.D.: 1

PROJECT:

MAJOR SITE PLAN AMENDMENT

FOR

29TH PLACE DRIVE THRU

LOCATION

1500 SEMINOLE TRAIL
CHARLOTTESVILLE, VA 22901
ALBEMARLE COUNTY

BOHLER
28 BLACKWELL PARK LANE, SUITE 201
WARRENTON, VIRGINIA 20186
Phone: (540) 349-4500
Fax: (540) 349-0321
VA@BohlerEng.com

COMMONWEALTH OF VIRGINIA
RYAN YAUGER
Lic. No. 0402056625
6/18/2020
PROFESSIONAL ENGINEER

SHEET TITLE:

COVER SHEET

SHEET NUMBER:

C-100

REVISION 1 - 6/18/2020

H:\V194600\CAD\WINGSPLAN DETAIL\V194600-SHT1-3---LAYOUT C-100- COVER

GENERAL NOTES

(Rev. 1/2020)

1. THESE PLANS ARE SOLELY BASED ON INFORMATION THE OWNER AND OTHERS PROVIDED TO BOHLER ENGINEERING, (HEREIN "BOHLER") PRIOR TO THE DATE ON WHICH ENGINEER PREPARED THESE PLANS. THE CONTRACTOR MUST FIELD VERIFY ALL EXISTING CONDITIONS AND IMMEDIATELY NOTIFY BOHLER , IN WRITING, IF ANY ACTUAL SITE CONDITIONS DIFFER FROM THOSE SHOWN ON THESE PLANS, OR IF THE PROPOSED WORK CONFLICTS WITH ANY OTHER SITE FEATURES.
2. THE CONTRACTOR MUST STRICTLY COMPLY WITH THESE NOTES AND ALL SPECIFICATIONS/REPORTS CONTAINED HEREIN. THE CONTRACTOR MUST ENSURE THAT ALL SUBCONTRACTORS FULLY AND COMPLETELY CONFORM TO AND COMPLY WITH THESE REQUIREMENTS, THESE NOTES, AND THE REQUIREMENTS ARTICULATED IN THE NOTES CONTAINED IN ALL THE OTHER DRAWINGS THAT COMPRISE THE PLAN SET OF DRAWINGS. ADDITIONAL NOTES AND SPECIFIC PLAN NOTES MAY BE FOUND ON THE INDIVIDUAL PLANS. THESE GENERAL NOTES APPLY TO THIS ENTIRE DOCUMENT PACKAGE. IT IS THE CONTRACTOR'S RESPONSIBILITY TO REVIEW ALL CONSTRUCTION CONTRACT DOCUMENTS INCLUDING, BUT NOT LIMITED TO, ALL OF THE DRAWINGS AND SPECIFICATIONS ASSOCIATED WITH THE PROJECT WORK SCOPE, PRIOR TO THE INITIATION AND COMMENCEMENT OF CONSTRUCTION.
3. PRIOR TO THE COMMENCEMENT OF CONSTRUCTION, THE CONTRACTOR MUST CONFIRM WITH THE ENGINEER OF RECORD THAT THE LATEST EDITION OF THE DOCUMENTS AND/OR REPORTS REFERENCED WITHIN THE PLAN REFERENCES ARE BEING USED FOR CONSTRUCTION. THIS IS THE CONTRACTOR'S SOLE AND COMPLETE RESPONSIBILITY.
4. PRIOR TO THE COMMENCEMENT OF CONSTRUCTION, THE CONTRACTOR MUST ENSURE THAT ALL REQUIRED PERMITS AND APPROVALS HAVE BEEN OBTAINED. NO CONSTRUCTION WORK SHALL COMMENCE OR BE ALLOWED TO PROCEED UNTIL THE CONTRACTOR HAS RECEIVED AND THOROUGHLY REVIEWED THE CONDITIONS OF APPROVAL TO ALL PLANS AND OTHER DOCUMENTS REVIEWED AND APPROVED BY THE PERMITTING AUTHORITIES AND HAS ALSO CONFIRMED THAT ALL NECESSARY AND REQUIRED PERMITS HAVE BEEN OBTAINED. THE CONTRACTOR MUST HAVE COPIES OF ALL PERMITS AND APPROVALS ON SITE AT ALL TIMES.
5. THE CONTRACTOR MUST ENSURE THAT ALL WORK IS PERFORMED IN ACCORDANCE WITH THESE PLANS, SPECIFICATIONS/REPORTS AND CONDITIONS OF APPROVAL, AND ALL APPLICABLE REQUIREMENTS, RULES, REGULATIONS, STATUTORY REQUIREMENTS, CODES, LAWS AND STANDARDS OF ALL GOVERNMENTAL ENTITIES WITH JURISDICTION OVER THIS PROJECT, AND ALL PROVISIONS IN AND CONDITIONS OF THE CONSTRUCTION CONTRACT WITH THE OWNER/DEVELOPER INCLUDING ALL EXHIBITS, ATTACHMENTS AND ADDENDA TO SAME.
6. PRIOR TO THE COMMENCEMENT OF CONSTRUCTION, THE CONTRACTOR MUST COORDINATE THE BUILDING LAYOUT BY CAREFULLY REVIEWING THE MOST CURRENT ARCHITECTURAL, CIVIL AND STRUCTURAL CONSTRUCTION DOCUMENTS INCLUDING, BUT NOT LIMITED TO, MECHANICAL, ELECTRICAL, PLUMBING AND FIRE SUPPRESSION PLANS, WHERE APPLICABLE). THE CONTRACTOR MUST IMMEDIATELY NOTIFY OWNER, ARCHITECT AND ENGINEER OF RECORD, IN WRITING, OF ANY CONFLICTS, DISCREPANCIES OR AMBIGUITIES WHICH EXIST BETWEEN THESE PLANS AND THE OTHER PLANS THAT COMPRISE THE CONSTRUCTION DOCUMENTS.
7. CONTRACTOR MUST REFER TO AND ENSURE COMPLIANCE WITH THE APPROVED ARCHITECTURAL/BUILDING PLANS OF RECORD FOR EXACT LOCATIONS AND DIMENSIONS OF ENTRY/EXIT POINTS, ELEVATIONS, PRECISE BUILDING DIMENSIONS, AND EXACT BUILDING UTILITY LOCATIONS.
8. THE CONTRACTOR MUST FIELD VERIFY ALL DIMENSIONS AND MEASUREMENTS SHOWN ON THESE PLANS, PRIOR TO THE COMMENCEMENT OF CONSTRUCTION. THE CONTRACTOR MUST IMMEDIATELY NOTIFY ENGINEER OF RECORD, IN WRITING, IF ANY CONFLICTS, DISCREPANCIES, OR AMBIGUITIES EXIST PRIOR TO PROCEEDING WITH CONSTRUCTION. NO EXTRA COMPENSATION WILL BE PAID TO THE CONTRACTOR DUE TO DIFFERENCES BETWEEN ACTUAL DIMENSIONS, MEASUREMENTS OR GRADES SHOWN INCORRECTLY ON THESE PLANS PRIOR TO BOTH (A) THE CONTRACTOR GIVING ENGINEER OF RECORD WRITTEN NOTIFICATION OF SAME AND (B) ENGINEER OF RECORD, THEREAFTER, PROVIDING THE CONTRACTOR WITH WRITTEN AUTHORIZATION TO PROCEED WITH SUCH ADDITIONAL WORK.
9. THE CONTRACTOR MUST VERIFY ALL DIMENSIONS AND MEASUREMENTS INCLUDED ON DESIGN DOCUMENTS HEREIN AND MUST NOT SCALE OFF THE DRAWINGS DUE TO POTENTIAL PRINTING INACCURACIES. ALL DIMENSIONS AND MEASUREMENTS ARE TO BE CHECKED AND CONFIRMED BY THE GENERAL CONTRACTOR PRIOR TO PREPARATION OF SHOP DRAWINGS, FABRICATION/ORDERING OF PARTS AND MATERIALS AND COMMENCEMENT OF SITE WORK. SITE PLAN DRAWINGS ARE NOT INTENDED AS SURVEY DOCUMENTS. DIMENSIONS SUPERSEDE GRAPHICAL REPRESENTATIONS. THE CONTRACTOR MUST MAKE CONTRACTOR'S OWN MEASUREMENTS FOR LAYOUT IMPROVEMENTS.
10. THE OWNER AND CONTRACTOR MUST BE FAMILIAR WITH, AND RESPONSIBLE FOR THE PROCUREMENT OF ANY AND ALL CERTIFICATIONS REQUIRED FOR THE ISSUANCE OF A CERTIFICATE OF OCCUPANCY.
11. WHEN INCLUDED AS PART OF THE REFERENCED DOCUMENTS, THE GEOTECHNICAL REPORT, SPECIFICATIONS AND RECOMMENDATIONS SET FORTH THEREIN ARE A PART OF THE REQUIRED CONSTRUCTION DOCUMENTS AND, IN CASE OF CONFLICT, DISCREPANCY OR AMBIGUITY, THE MORE STRINGENT REQUIREMENTS AND/OR RECOMMENDATIONS CONTAINED IN: (A) THE PLANS; AND (B) THE GEOTECHNICAL REPORT AND RECOMMENDATIONS, MUST TAKE PRECEDENCE UNLESS SPECIFICALLY NOTED OTHERWISE ON THE PLANS. THE CONTRACTOR MUST NOTIFY THE ENGINEER OF RECORD, IN WRITING, OF ANY SUCH CONFLICT, DISCREPANCY OR AMBIGUITY BETWEEN THE GEOTECHNICAL REPORT AND PLANS AND SPECIFICATIONS, PRIOR TO PROCEEDING WITH ANY FURTHER WORK. IF A GEOTECHNICAL REPORT WAS NOT CREATED, THEN THE CONTRACTOR MUST FOLLOW AND COMPLY WITH ALL OF THE REQUIREMENTS OF ANY AND ALL MUNICIPAL, COUNTY, STATE, AND FEDERAL LAWS AND APPLICABLE SPECIFICATIONS WHICH HAVE JURISDICTION OVER THIS PROJECT.
12. ENGINEER OF RECORD IS NEITHER LIABLE NOR RESPONSIBLE FOR ANY SUBSURFACE CONDITIONS AND FURTHER, HAS NO LIABILITY FOR ANY HAZARDOUS MATERIALS, HAZARDOUS SUBSTANCES, OR POLLUTANTS ON, ABOUT OR UNDER THE PROPERTY.
13. THE CONTRACTOR IS RESPONSIBLE FOR IDENTIFYING WHEN AND WHERE SHORING IS REQUIRED AND FOR INSTALLING ALL SHORING REQUIRED DURING EXCAVATION (TO BE PERFORMED IN ACCORDANCE WITH CURRENT OSHA STANDARDS) AND ANY ADDITIONAL PRECAUTIONS TO BE TAKEN TO ASSURE THE SAFETY, INTEGRITY AND CONTIGUOUS STRUCTURES AND PROPERTIES. ALL OF THIS WORK IS TO BE PERFORMED AT CONTRACTOR'S SOLE COST AND EXPENSE.
14. THE CONTRACTOR MUST EXERCISE EXTREME CAUTION WHEN PERFORMING ANY WORK ACTIVITIES ADJACENT TO PAVEMENT, STRUCTURES, ETC. WHICH ARE TO REMAIN EITHER FOR AN INITIAL PHASE OF THE PROJECT OR AS PART OF THE FINAL CONDITION. THE CONTRACTOR IS RESPONSIBLE FOR TAKING ALL NECESSARY PRECAUTIONS TO ENSURE THE STRUCTURAL STABILITY OF SIDEWALKS AND PAVEMENT, UTILITIES, BUILDINGS, AND INFRASTRUCTURE WHICH ARE TO REMAIN, AND TO PROVIDE A SAFE WORK AREA FOR THIRD PARTIES, PEDESTRIANS AND ANYONE INVOLVED WITH THE PROJECT.
15. DEBRIS MUST NOT BE BURIED ON THE SUBJECT SITE. DEMOLITION AND CONSTRUCTION WASTES, UNSUITABLE EXCAVATED MATERIAL, EXCESS SOIL AND DEBRIS (SOLID WASTE) MUST BE DISPOSED OF IN ACCORDANCE WITH THE REQUIREMENTS OF ANY AND ALL MUNICIPAL, COUNTY, STATE, AND FEDERAL LAWS AND APPLICABLE CODES WHICH HAVE JURISDICTION OVER THIS PROJECT OR OVER THE CONTRACTOR.
16. IT IS THE CONTRACTOR'S SOLE RESPONSIBILITY TO MAINTAIN RECORDS TO DEMONSTRATE PROPER AND FULLY COMPLIANT DISPOSAL ACTIVITIES, TO BE PROMPTLY PROVIDED TO THE OWNER UPON REQUEST.
17. THE CONTRACTOR FOR ANY DAMAGE DONE TO ANY NEW OR EXISTING CONSTRUCTION OR PROPERTY DURING THE COURSE OF CONSTRUCTION, INCLUDING BUT NOT LIMITED TO DRAINAGE, UTILITIES, PAVEMENT, STRIPING, CURB, ETC. AND MUST BEAR ALL COSTS ASSOCIATED WITH SAME TO INCLUDE, BUT NOT BE LIMITED TO, REDESIGN, RE-SURVEY, RE-PERMITTING AND CONSTRUCTION. THE CONTRACTOR IS RESPONSIBLE FOR AND MUST REPLACE ALL SIGNAL INTERCONNECTION CABLE, WIRING CONDUITS, AND ANY UNDERGROUND CONSTRUCTION AND/OR EQUIPMENT DAMAGED DURING CONSTRUCTION AND MUST BEAR ALL COSTS ASSOCIATED WITH SAME. THE REPAIR OF ANY SUCH NEW OR EXISTING CONSTRUCTION OR PROPERTY MUST RESTORE SUCH CONSTRUCTION OR PROPERTY TO A CONDITION EQUIVALENT TO OR BETTER THAN THE CONDITIONS PRIOR TO COMMENCEMENT OF THE CONSTRUCTION, AND IN CONFORMANCE WITH APPLICABLE CODES, LAWS, RULES, REGULATIONS, STATUTORY REQUIREMENTS AND STATUTES. THE CONTRACTOR MUST BEAR ALL COSTS ASSOCIATED WITH SAME. THE CONTRACTOR MUST, PROMPTLY, DOCUMENT ALL EXISTING DAMAGE AND NOTIFY, IN WRITING, THE OWNER AND THE CONSTRUCTION MANAGER PRIOR TO THE START OF CONSTRUCTION.
18. THE ENGINEER OF RECORD AND BOHLER ARE NOT RESPONSIBLE FOR AND HAVE NO CONTRACTUAL, LEGAL OR OTHER RESPONSIBILITIES FOR JOB SITE SAFETY JOB SITE SUPERVISION, OR ANYTHING RELATED TO SAME. THE ENGINEER OF RECORD AND BOHLER HAVE NOT BEEN RETAINED TO PERFORM OR TO BE RESPONSIBLE FOR JOB SITE SAFETY, SAME BEING WHOLLY OUTSIDE OF ENGINEER OF RECORD'S AND BOHLER SERVICES AS BOTH LATENT TO THE PROJECT. THE ENGINEER OF RECORD AND BOHLER ARE NOT RESPONSIBLE TO IDENTIFY OR REPORT ANY JOB SITE SAFETY ISSUES OR ANY JOB SITE CONDITIONS, AT ANY TIME.
19. THE CONTRACTOR MUST IMMEDIATELY IDENTIFY IN WRITING, TO THE ENGINEER OF RECORD AND BOHLER , ANY DISCREPANCIES THAT MAY OR COULD AFFECT THE PUBLIC SAFETY, HEALTH OR GENERAL WELFARE, OR PROJECT COST. IF THE CONTRACTOR PROCEEDS WITH CONSTRUCTION WITHOUT PROVIDING PRIOR WRITTEN NOTIFICATION AS DESCRIBED ABOVE, IT WILL BE AT THE CONTRACTOR'S OWN RISK AND, FURTHER, THE CONTRACTOR MUST INDEMNIFY, DEFEND AND HOLD HARMLESS THE ENGINEER OF RECORD AND BOHLER FOR ANY AND ALL DAMAGES, COSTS, INJURIES, ATTORNEY'S FEES AND THE LIKE WHICH RESULT FROM OR ARE IN ANY WAY RELATED TO SAME INCLUDING, BUT NOT LIMITED TO, ANY THIRD PARTY AND/OR FIRST PARTY CLAIMS.
20. THE ENGINEER OF RECORD AND BOHLER ARE NOT RESPONSIBLE FOR ANY INJURY OR DAMAGES RESULTING FROM THE CONTRACTOR'S FAILURE TO BUILD OR CONSTRUCT IN STRICT ACCORDANCE WITH THE APPROVED PLANS, AND CURRENT CODES, RULES, STATUTES AND THE LIKE. IF THE CONTRACTOR AND/OR OWNER FAIL TO BUILD OR CONSTRUCT IN STRICT ACCORDANCE WITH APPROVED PLANS, RULES, STATUTES, CODES AND THE LIKE, THE CONTRACTOR AND/OR OWNER AGREE TO AND MUST JOINTLY, INDEPENDENTLY, SEPARATELY, AND SEVERALLY INDEMNIFY AND HOLD THE ENGINEER OF RECORD AND BOHLER HARMLESS FOR AND FROM ALL INJURIES, CLAIMS AND DAMAGES THAT ENGINEER AND BOHLER SUFFER AND ANY AND ALL COSTS THAT ENGINEER AND BOHLER INCUR AS RELATED TO SAME.
21. ALL CONTRACTORS MUST CARRY AT LEAST THE MINIMUM AMOUNT OF THE SPECIFIED AND COMMERCIALLY REASONABLE STATUTORY WORKER'S COMPENSATION INSURANCE, EMPLOYER'S LIABILITY INSURANCE AND COMMERCIAL GENERAL LIABILITY INSURANCE (CGL) INCLUDING ALSO ALL UMBRELLA COVERAGES AS ARE APPROPRIATE FOR THE PROJECT. ALL CONTRACTORS MUST HAVE THEIR CGL POLICIES ENDORSED TO ADD THE OWNER, ENGINEER OF RECORD, BOHLER, AND ITS PAST, PRESENT AND FUTURE OWNERS, OFFICERS, DIRECTORS, PARTNERS, SHAREHOLDERS, MEMBERS, PRINCIPALS, COMMISSIONERS, AGENTS, SERVANTS, EMPLOYEES, AFFILIATES, SUBSIDIARIES, AND RELATED ENTITIES, AND ITS SUBCONTRACTORS AND SUBCONSULTANTS AS ADDITIONAL NAMED INSUREDS AND TO PROVIDE CONTRACTUAL LIABILITY COVERAGE SUFFICIENT TO INSURE THE (DEFEND, IF APPLICABLE) AND HOLD HARMLESS AND INDEMNITY OBLIGATIONS ASSUMED AND AGREED TO BY THE CONTRACTOR HEREIN. ALL CONTRACTORS MUST FURNISH BOHLER WITH CERTIFICATIONS OF INSURANCE OR CERTIFICATES OF INSURANCE AS EVIDENCE OF THE REQUIRED INSURANCE COVERAGES PRIOR TO COMMENCING ANY WORK AND UPON RENEWAL OF EACH POLICY DURING THE ENTIRE PERIOD OF CONSTRUCTION AND FOR TWO YEARS AFTER THE COMPLETION OF CONSTRUCTION AND AFTER ALL PERMITS ARE ISSUED, WHICHEVER DATE IS LATER. IN ADDITION, ALL CONTRACTORS AGREE THAT THEY WILL, TO THE FULLEST EXTENT PERMITTED UNDER THE LAW, INDEMNIFY, DEFEND AND HOLD HARMLESS BOHLER AND ITS PAST, PRESENT AND FUTURE OWNERS, OFFICERS, DIRECTORS, PARTNERS, SHAREHOLDERS, MEMBERS, PRINCIPALS, COMMISSIONERS, AGENTS, SERVANTS, EMPLOYEES, AFFILIATES, SUBSIDIARIES, AND RELATED ENTITIES, AND ITS SUBCONTRACTORS AND SUBCONSULTANTS FROM AND AGAINST ANY DAMAGES, INJURIES, CLAIMS, ACTIONS, PENALTIES, EXPENSES, PUNITIVE DAMAGES, TORT DAMAGES, STATUTORY CLAIMS, STATUTORY CAUSES OF ACTION, LOSSES, CAUSES OF ACTION, LIABILITIES OR COSTS, INCLUDING, BUT NOT LIMITED TO, REASONABLE ATTORNEYS' FEES AND DEFENSE COSTS, ARISING OUT OF OR IN ANY WAY CONNECTED WITH OR TO THE PROJECT, INCLUDING ALL CLAIMS BY EMPLOYEES OF THE CONTRACTOR(S), ALL CLAIMS BY THIRD PARTIES AND ALL CLAIMS RELATED TO THE PROJECT. THE CONTRACTOR MUST NOTIFY ENGINEER, IN WRITING, AT LEAST THIRTY (30) DAYS PRIOR TO ANY TERMINATION, SUSPENSION OR CHANGE OF ITS INSURANCE HEREUNDER.
22. THE ENGINEER OF RECORD AND BOHLER ARE NOT RESPONSIBLE FOR CONSTRUCTION METHODS, MEANS, TECHNIQUES OR PROCEDURES, GENERALLY OR FOR THE CONSTRUCTION MEANS, METHODS, TECHNIQUES OR PROCEDURES FOR COMPLETION OF THE WORK DEPICTED BOTH ON THESE PLANS, AND FOR ANY CONFLICTS IN SCOPE AND REVISIONS THAT RESULT FROM SAME. THE CONTRACTOR IS FULLY AND SOLELY RESPONSIBLE FOR DETERMINING THE MEANS AND METHODS FOR COMPLETION OF THE WORK, PRIOR TO THE COMMENCEMENT OF CONSTRUCTION.
23. NEITHER THE PROFESSIONAL ACTIVITIES OF: BOHLER , NOR THE PRESENCE OF BOHLER AND/OR ITS PAST, PRESENT AND FUTURE OWNERS, OFFICERS, DIRECTORS, PARTNERS, SHAREHOLDERS, MEMBERS, PRINCIPALS, COMMISSIONERS, AGENTS, SERVANTS, EMPLOYEES, AFFILIATES, SUBSIDIARIES, AND RELATED ENTITIES, AND ITS SUBCONTRACTORS AND SUBCONSULTANTS AT A CONSTRUCTION/PROJECT SITE (HEREIN "BOHLER PARTIES"), RELIEVES OR WILL RELIEVE THE CONTRACTOR OF AND FROM ITS OBLIGATIONS, DUTIES AND RESPONSIBILITIES INCLUDING, BUT NOT LIMITED TO, CONSTRUCTION MEANS, METHODS, SEQUENCE, TECHNIQUES OR PROCEDURES NECESSARY FOR PERFORMING, OVERSEEING, SUPERINTENDING AND COORDINATING THE WORK IN ACCORDANCE WITH THE CONTRACT DOCUMENTS AND COMPLIANCE WITH ALL HEALTH AND SAFETY PRECAUTIONS REQUIRED BY ANY REGULATORY AGENCIES WITH JURISDICTION OVER THE PROJECT AND/OR PROPERTY. BOHLER AND ITS EMPLOYEES, PERSONNEL, AGENTS, SUBCONTRACTORS AND SUBCONSULTANTS HAVE NO AUTHORITY TO EXERCISE ANY CONTROL OVER (OR ANY RESPONSIBILITY FOR) ANY CONSTRUCTION, THE CONTRACTOR OR ITS EMPLOYEES RELATING TO HEALTH AND SAFETY AND ALL HEALTH AND SAFETY PROGRAMS OR PROCEDURES. THE CONTRACTOR IS SOLELY RESPONSIBLE FOR JOB SITE SAFETY. THE CONTRACTOR MUST INDEMNIFY, DEFEND, PROTECT AND HOLD HARMLESS BOHLER FOR AND FROM ANY LIABILITY TO BOHLER RESULTING FROM THE CONTRACTOR'S WORK, SERVICES AND/OR VIOLATIONS OF THIS NOTE. THESE NOTES OR ANY NOTES IN THE PLAN SET AND, FURTHER, THE CONTRACTOR MUST NAME BOHLER AS AN ADDITIONAL INSURED UNDER THE GENERAL CONTRACTOR'S POLICIES OF GENERAL LIABILITY INSURANCE AS DESCRIBED ABOVE.
24. WHEN IT IS CLEARLY AND SPECIFICALLY WITHIN BOHLER'S SCOPE OF SERVICES CONTRACT WITH THE OWNER/DEVELOPER, BOHLER WILL REVIEW OR TAKE OTHER APPROPRIATE ACTION ON THE CONTRACTOR SUBMITTALS, SUCH AS SHOP DRAWINGS, PRODUCT DATA, SAMPLES, AND OTHER DATA, WHICH THE CONTRACTOR IS REQUIRED TO SUBMIT, BUT ONLY FOR THE LIMITED PURPOSE OF EVALUATING CONFORMANCE WITH THE DESIGN INTENT AND THE INFORMATION SHOWN IN THE CONSTRUCTION CONTRACT DOCUMENTS. CONSTRUCTION MEANS AND METHODS AND/OR TECHNIQUES OR PROCEDURES, COORDINATION OF THE WORK WITH OTHER TRADES, AND CONSTRUCTION SAFETY PRECAUTIONS ARE THE SOLE RESPONSIBILITY OF THE CONTRACTOR AND BOHLER HAS NO RESPONSIBILITY OR LIABILITY FOR SAME. BOHLER WILL PERFORM ITS SHOP DRAWING REVIEW WITH REASONABLE PROMPTNESS, AS CONDITIONS PERMIT. ANY DOCUMENT, DOCUMENTING BOHLERS REVIEW OF A SPECIFIC ITEM OR LIMITED SCOPE, MUST NOT INDICATE THAT BOHLER HAS REVIEWED THE ENTIRE ASSEMBLY OF WHICH THE ITEM IS A COMPONENT. BOHLER IS NOT RESPONSIBLE FOR ANY DEVIATIONS FROM THE CONSTRUCTION DOCUMENTS. THE CONTRACTOR MUST, IN WRITING, PROMPTLY AND IMMEDIATELY BRING ANY DEVIATIONS FROM THE CONSTRUCTION DOCUMENTS TO BOHLERS ATTENTION. BOHLER IS NOT REQUIRED TO REVIEW PARTIAL SUBMISSIONS OR THOSE FOR WHICH SUBMISSIONS OF CORRELATED ITEMS HAVE NOT BEEN RECEIVED.
25. IF THE CONTRACTOR DEVIATES FROM THESE PLANS AND/OR SPECIFICATIONS, INCLUDING THE NOTES CONTAINED HEREIN, WITHOUT FIRST OBTAINING THE PRIOR WRITTEN AUTHORIZATION OF THE ENGINEER OF RECORD AND/OR BOHLER FOR ALL DEVIATIONS WITHIN ENGINEER'S SCOPE, THE CONTRACTOR IS SOLELY RESPONSIBLE FOR THE PAYMENT OF ALL COSTS INCURRED IN CORRECTING ANY WORK PERFORMED WHICH DEVIATES FROM THE PLANS, ALL FINES AND/OR PENALTIES ASSESSED WITH RESPECT THERETO AND ALL COMPENSATORY OR PUNITIVE DAMAGES RESULTING THEREFROM AND, FURTHER, MUST DEFEND, INDEMNIFY, PROTECT, AND HOLD HARMLESS THE ENGINEER OF RECORD AND BOHLER PARTIES TO THE FULLEST EXTENT PERMITTED UNDER THE LAW, FOR AND FROM ALL FEES, ATTORNEYS' FEES, DAMAGES, COSTS, JUDGMENTS, CLAIMS, INJURIES, PENALTIES AND THE LIKE RELATED TO SAME.
26. THE CONTRACTOR IS RESPONSIBLE FOR A MAINTAINING AND PROTECTING THE TRAFFIC CONTROL PLAN AND ELEMENTS IN ACCORDANCE WITH FEDERAL, STATE, AND LOCAL REQUIREMENTS, FOR ALL WORK THAT AFFECTS PUBLIC TRAVEL EITHER IN THE RIGHT OF WAY OR ON SITE. THE COST FOR THIS ITEM MUST BE INCLUDED IN THE CONTRACTOR'S PRICE AND IS THE CONTRACTOR'S SOLE RESPONSIBILITY.
27. OWNER MUST MAINTAIN AND PRESERVE ALL PHYSICAL SITE FEATURES AND DESIGN FEATURES DEPICTED ON THE PLANS AND RELATED DOCUMENTS IN STRICT ACCORDANCE WITH THE APPROVED PLAN(S) AND DESIGN; AND, FURTHER, THE ENGINEER OF RECORD AND/OR BOHLER ARE NOT RESPONSIBLE FOR ANY FAILURE TO SO MAINTAIN OR PRESERVE SITE AND/OR DESIGN FEATURES. IF OWNER FAILS TO MAINTAIN AND/OR PRESERVE ALL PHYSICAL SITE FEATURES AND/OR DESIGN FEATURES DEPICTED ON THE PLANS AND RELATED DOCUMENTS, OWNER AGREES TO INDEMNIFY AND HOLD THE ENGINEER OF RECORD AND BOHLER PARTIES, HARMLESS FOR ALL INJURIES, DAMAGES AND COSTS THAT THE ENGINEER OF RECORD AND/OR BOHLER INCUR AS A RESULT OF SAID FAILURE OR FAILURE TO PRESERVE.
28. THE CONTRACTOR IS SOLELY RESPONSIBLE FOR ENSURING THAT ALL CONSTRUCTION ACTIVITIES AND MATERIALS COMPLY WITH AND CONFORM TO APPLICABLE FEDERAL, STATE AND LOCAL RULES AND REGULATIONS, LAWS, ORDINANCES, AND CODES, AND ALL APPLICABLE REQUIREMENTS OF THE OCCUPATIONAL SAFETY AND HEALTH ACT OF 1970, (29 U.S.C. 651 ET SEQ.) AS AMENDED, AND ANY MODIFICATIONS, AMENDMENTS OR REVISIONS TO SAME.
29. THE CONTRACTOR MUST STRICTLY COMPLY WITH THE LATEST AND CURRENT OSHA STANDARDS AND REGULATIONS, AND/OR ANY OTHER AGENCY WITH JURISDICTION OVER EXCAVATION AND TRENCHING PROCEDURES. ENGINEER OF RECORD AND BOHLER HAS NO RESPONSIBILITY FOR OR AS RELATED TO EXCAVATION AND TRENCHING PROCEDURES AND WORK.
30. THE CONTRACTOR AND THE CONTRACTOR'S SUBCONTRACTORS MUST STRICTLY COMPLY WITH AND IN ACCORDANCE WITH MANUFACTURER'S STANDARDS AND RECOMMENDED INSTALLATION CRITERIA AND SPECIFICATIONS. IF THE CONTRACTOR AND/OR OWNER FAIL TO DO SO, THEY AGREE TO JOINTLY, INDEPENDENTLY, SEPARATELY, COLLECTIVELY, AND SEVERALLY INDEMNIFY, DEFEND, PROTECT AND HOLD ENGINEER OF RECORD AND BOHLER PARTIES HARMLESS FOR ALL INJURIES AND DAMAGES THAT ENGINEER SUFFERS AND COSTS THAT ENGINEER INCURS AS A RESULT OF SAID FAILURE.
31. THE CONTRACTOR IS RESPONSIBLE TO MAINTAIN AN ON-SITE STORMWATER POLLUTION PREVENTION PLAN (SWPPP) IN COMPLIANCE WITH THE ENVIRONMENTAL PROTECTION AGENCY (EPA) REQUIREMENTS OR LOCAL GOVERNING AGENCY FOR SITES WHERE ONE (1) ACRE OR MORE IS DISTURBED (INCLUDING THESE TOTAL DISTURBANCE ACTIVITIES (UNLESS THE LOCAL JURISDICTION REQUIRES A DIFFERENT THRESHOLD). THE CONTRACTOR MUST ENSURE THAT ALL ACTIVITIES, INCLUDING THOSE OF ALL SUBCONTRACTORS, ARE IN COMPLIANCE WITH THE SWPPP. INCLUDING BUT NOT LIMITED TO LOGGING ACTIVITIES (MINIMUM ONCE PER WEEK AND AFTER RAINFALL EVENTS) AND SUBMITTING REPORTS AS APPROPRIATE AND FURTHER, THE CONTRACTOR IS SOLELY AND COMPLETELY RESPONSIBLE FOR FAILING TO DO SO.
32. AS CONTAINED IN THESE DRAWINGS AND ASSOCIATED DOCUMENTS PREPARED BY THE SIGNATORY PROFESSIONAL ENGINEER OF RECORD, THE USE OF THE WORDS CERTIFICATION OR CERTIFY OR CERTIFICATION CONSTITUTE(S) AN EXPRESSION ONLY OF PROFESSIONAL OPINION REGARDING THE INFORMATION WHICH IS THE SUBJECT OF THE ENGINEER OF RECORD'S KNOWLEDGE OR BELIEF AND IN ACCORDANCE WITH COMMON AND ACCEPTED PROCEDURE CONSISTENT WITH THE APPLICABLE STANDARDS OF PRACTICE, AND DOES NOT CONSTITUTE A WARRANTY OR GUARANTEE OF ANY NATURE OR TYPE, EITHER EXPRESSED OR IMPLIED, UNDER ANY CIRCUMSTANCES.

SITE LAYOUT NOTES

(Rev. 1/2020)

1. THE GENERAL NOTES MUST BE INCLUDED AS PART OF THIS ENTIRE DOCUMENT PACKAGE AND ARE PART OF THE CONTRACT DOCUMENTS. THE GENERAL NOTES ARE REFERENCED HEREIN, AND THE CONTRACTOR MUST REFER TO THEM AND FULLY COMPLY WITH THESE NOTES, IN THEIR ENTIRETY. THE CONTRACTOR MUST BE FAMILIAR WITH AND ACKNOWLEDGE FAMILIARITY WITH ALL OF THE GENERAL NOTES AND ALL OF THE PLANS' SPECIFIC NOTES.
2. PRIOR TO THE COMMENCEMENT OF GENERAL CONSTRUCTION, THE CONTRACTOR MUST INSTALL SOIL EROSION CONTROL AND ANY STORMWATER POLLUTION PREVENTION PLAN (SWPPP) MEASURES NECESSARY, AS INDICATED ON THE APPROVED SOIL EROSION AND SEDIMENT CONTROL PLAN AND IN ACCORDANCE WITH APPLICABLE AND/OR APPROPRIATE AGENCIES' GUIDELINES TO PREVENT SEDIMENT AND/OR LOOSE DEBRIS FROM WASHING ONTO ADJACENT PROPERTIES OR THE RIGHT OF WAY.
3. ALL DIRECTIONAL/TRAFFIC SIGNING AND PAVEMENT STRIPING MUST CONFORM TO THE LATEST STANDARDS OF THE MANUAL ON UNIFORM TRAFFIC CONTROL DEVICES (MUTCD) AND ANY APPLICABLE STATE OR LOCALLY APPROVED SUPPLEMENTS, GUIDELINES, RULES, REGULATIONS, STANDARDS AND THE LIKE.
4. THE LOCATIONS OF PROPOSED UTILITY POLES AND TRAFFIC SIGNS SHOWN ON THE PLANS ARE SCHEMATIC AND PRELIMINARY. THE CONTRACTOR IS SOLELY RESPONSIBLE FOR FIELD-VERIFYING THEIR LOCATION. THE CONTRACTOR MUST COORDINATE THE RELOCATION OF TRAFFIC SIGNS WITH THE ENTITY WITH JURISDICTION OVER THE PROJECT.
5. ALL DIMENSIONS SHOWN ON THE PLANS ARE TO FACE OF CURB, EDGE OF PAVEMENT, OR EDGE OF BUILDING, EXCEPT WHEN DIMENSION IS TO A PROPERTY LINE, STAKE OUT OF LOCATIONS OF INLETS, LIGHT POLES, ETC. MUST BE PERFORMED IN STRICT ACCORDANCE WITH THE DETAILS, UNLESS NOTED CLEARLY OTHERWISE.

GRADING NOTES

(Rev.1/2020)

1. THE GENERAL NOTES MUST BE INCLUDED AS PART OF THIS ENTIRE DOCUMENT PACKAGE AND ARE PART OF THE CONTRACT DOCUMENTS. THE GENERAL NOTES ARE REFERENCED HEREIN, AND THE CONTRACTOR MUST REFER TO THEM AND FULLY COMPLY WITH THESE NOTES, IN THEIR ENTIRETY. THE CONTRACTOR MUST BE FAMILIAR WITH AND ACKNOWLEDGE FAMILIARITY WITH ALL OF THE GENERAL NOTES AND ALL OF THE PLANS' SPECIFIC NOTES.
2. SITE GRADING MUST STRICTLY CONFORM TO THE GRADING PLANS AND SPECIFICATIONS AND THE RECOMMENDATIONS SET FORTH IN THE GEOTECHNICAL REPORT AS REFERENCED IN THIS PLAN SET. IF NO GEOTECHNICAL REPORT HAS BEEN REFERENCED, THE CONTRACTOR MUST HAVE A GEOTECHNICAL ENGINEER PROVIDE WRITTEN SPECIFICATIONS AND RECOMMENDATIONS PRIOR TO PROCEEDING WITH GRADING ACTIVITIES. THE CONTRACTOR MUST ALLOW THE REQUIREMENTS OF ALL MUNICIPAL, COUNTY, STATE, AND FEDERAL LAWS, WHICH HAVE JURISDICTION OVER THIS PROJECT.
3. THE CONTRACTOR IS REQUIRED TO SECURE ALL NECESSARY AND/OR REQUIRED PERMITS AND APPROVALS FOR ALL OFF-SITE MATERIAL SOURCES AND DISPOSAL FACILITIES AND THE CONTRACTOR MUST SUPPLY A COPY OF APPROVALS TO THE ENGINEER OF RECORD AND THE OWNER PRIOR TO THE CONTRACTOR COMMENCING ANY WORK.
4. THE CONTRACTOR IS FULLY RESPONSIBLE FOR VERIFYING EXISTING TOPOGRAPHIC INFORMATION AND UTILITY INVERT ELEVATIONS PRIOR TO COMMENCING ANY CONSTRUCTION. SHOULD DISCREPANCIES BETWEEN THE PLANS AND INFORMATION OBTAINED THROUGH FIELD VERIFICATIONS BE IDENTIFIED OR EXIST, THE CONTRACTOR MUST IMMEDIATELY NOTIFY THE ENGINEER OF RECORD, IN WRITING.
5. THE CONTRACTOR IS RESPONSIBLE FOR REMOVING AND REPLACING ALL UNSUITABLE MATERIALS WITH SUITABLE MATERIALS AS SPECIFIED IN THE GEOTECHNICAL REPORT. THE ESTIMATED QUANTITIES OF REMOVAL AND REPLACEMENT MUST BE VERIFIED IN ACCORDANCE WITH THE GEOTECHNICAL REPORT'S GUIDANCE. MOISTURE CONTENT AT TIME OF PLACEMENT MUST BE SUBMITTED IN A COMPACTION REPORT PREPARED BY A QUALIFIED GEOTECHNICAL ENGINEER, REGISTERED WITH THE STATE WHERE THE WORK IS PERFORMED. THIS REPORT MUST VERIFY THAT ALL FILLED AREAS AND SUBGRADE AREAS WITHIN THE BUILDING PAD AREA AND AREAS TO BE PAVED HAVE BEEN COMPACTED IN ACCORDANCE WITH THESE PLANS, SPECIFIC

ACSA GENERAL WATER AND SEWER CONDITIONS:

1. WORK SHALL BE SUBJECT TO INSPECTION BY ALBEMARLE COUNTY SERVICE AUTHORITY) ACSA INSPECTORS. THE CONTRACTOR WILL BE RESPONSIBLE FOR NOTIFYING THE PROPER ACSA OFFICIALS AT THE START OF THE WORK.
2. THE LOCATION OF EXISTING UTILITIES ACROSS THE LINE OF THE PROPOSED WORK ARE NOT NECESSARILY SHOWN ON THE PLANS AND WHERE SHOWN ARE ONLY APPROXIMATELY CORRECT. THE CONTRACTOR SHALL, ON HIS OWN INITIATIVE, LOCATE ALL UNDERGROUND LINES AND STRUCTURES, AS NECESSARY.
3. ALL MATERIALS AND CONSTRUCTION SHALL COMPLY WITH THE CURRENT EDITION OF THE GENERAL WATER AND SEWER CONSTRUCTION SPECIFICATIONS, AS ADOPTED BY THE ACSA.
4. DATUM FOR ALL ELEVATIONS SHOWN IN NATIONAL GEODETIC SURVEY.
5. THE CONTRACTOR SHALL BE RESPONSIBLE FOR NOTIFYING MISS UTILITY (1-800-552-7001).
6. ALL WATER AND SEWER PIPES SHALL HAVE A MINIMUM OF THREE (3) FEET OF COVER MEASURED FROM THE TOP OF PIPE, OVER THE CENTERLINE OF PIPE. THIS INCLUDES ALL FIRE HYDRANT LINES, SERVICE LATERALS AND WATER LINES, ETC.
7. ALL WATER AND SEWER APPURTENANCES ARE TO BE LOCATED OUTSIDE OF ROADSIDE DITCHES.
8. VALVES ON DEADEND LINES SHALL BE RODDED TO PROVIDE ADEQUATE RESTRAINT FOR THE VALVE DURING A FUTURE EXTENSION OF THE LINE.
9. TREES ARE NOT PERMITTED IN THE ACSA EASEMENT.
10. THE CONTRACTOR SHALL BE RESPONSIBLE TO COMPLY WITH THE NO-LEAD REGULATION REGARDING BRASS FITTINGS EFFECTIVE JANUARY 4, 2014 (SENATE BILL 3874 WHICH AMENDS THE SAFE DRINKING WATER ACT).

ALBEMARLE COUNTY ENGINEERING GENERAL CONSTRUCTION NOTES FOR SITE PLANS

1. PRIOR TO ANY CONSTRUCTION WITHIN ANY EXISTING PUBLIC RIGHT-OF-WAY, INCLUDING CONNECTION TO ANY EXISTING ROAD, A PERMIT SHALL BE OBTAINED FROM THE VIRGINIA DEPARTMENT OF TRANSPORTATION (VDOT). THIS PLAN AS DRAWN MAY NOT ACCURATELY REFLECT THE REQUIREMENTS OF THE PERMIT. WHERE ANY DISCREPANCIES OCCUR THE REQUIREMENTS OF THE PERMIT SHALL GOVERN.
2. ALL PAVING, DRAINAGE RELATED MATERIALS AND CONSTRUCTION METHODS SHALL CONFORM TO CURRENT SPECIFICATIONS AND STANDARDS OF VDOT UNLESS OTHERWISE NOTED.
3. EROSION AND SILTATION CONTROL MEASURES SHALL BE PROVIDED IN ACCORDANCE WITH THE APPROVED EROSION CONTROL PLAN AND SHALL BE INSTALLED PRIOR TO ANY CLEARING, GRADING OR OTHER CONSTRUCTION.
4. ALL SLOPES AND DISTURBED AREAS ARE TO BE FERTILIZED, SEEDED AND MULCHED. THE MAXIMUM ALLOWABLE SLOPE IS 2:1 (HORIZONTAL:VERTICAL). WHERE REASONABLY OBTAINABLE, LESSER SLOPES OF 3:1 OR BETTER ARE TO BE ACHIEVED.
5. PAVED, RIP-RAP OR STABILIZATION MAT LINED DITCH MAY BE REQUIRED WHEN IN THE OPINION OF THE ALBEMARLE COUNTY DIRECTOR OF ENGINEERING, OR THE DIRECTORS DESIGNEE, IT IS DEEMED NECESSARY IN ORDER TO STABILIZE A DRAINAGE CHANNEL.
6. ALL TRAFFIC CONTROL SIGNS SHALL CONFORM WITH THE VIRGINIA MANUAL FOR UNIFORM TRAFFIC CONTROL DEVICES.
7. UNLESS OTHERWISE NOTED ALL CONCRETE PIPE SHALL BE REINFORCED CONCRETE PIPE - CLASS III.
8. ALL EXCAVATION FOR UNDERGROUND PIPE INSTALLATION MUST COMPLY WITH OSHA STANDARDS FOR THE CONSTRUCTION INDUSTRY (29 CFR PART 1926).

STANDARD DRAWING LEGEND

FOR ENTIRE PLAN SET

EXISTING NOTE	TYPICAL NOTE TEXT	PROPOSED NOTE
LIMIT OF WORK		LOW LOW
LIMIT OF DISTURBANCE		LOD LOD
	ONSITE PROPERTY LINE / R.O.W. LINE	
	NEIGHBORING PROPERTY LINE / INTERIOR PARCEL LINE	
	EASEMENT LINE	
	SETBACK LINE	
	CONCRETE CURB & GUTTER	CURB AND GUTTER; SPILL; TRANSITION; DEPRESSED CURB AND GUTTER
	UTILITY POLE WITH LIGHT	
	POLE LIGHT	
	TRAFFIC LIGHT	
	UTILITY POLE	
	TYPICAL LIGHT	
	ACORN LIGHT	
	TYPICAL SIGN	
	PARKING COUNTS	X
170 / 169	CONTOUR LINE	190 / 187
TC 516.4 OR 516.4	SPOT ELEVATIONS	TC 516.00; TC 516.00 BC 515.55; MATCH EX (518.02 ±)
SAN #	SANITARY LABEL	SAN #
X #	STORM LABEL	X #
SL	SANITARY SEWER LATERAL	SL
W	UNDERGROUND WATER LINE	W
E	UNDERGROUND ELECTRIC LINE	E
G	UNDERGROUND GAS LINE	G
OH	OVERHEAD WIRE	OH
T	UNDERGROUND TELEPHONE LINE	T
C	UNDERGROUND CABLE LINE	C
	STORM SEWER	
S	SANITARY SEWER MAIN	S
	HYDRANT	
S	SANITARY MANHOLE	
D	STORM MANHOLE	
WM	WATER METER	
WV	WATER VALVE	
	GAS VALVE	
	GAS METER	
	TYPICAL END SECTION	
	HEADWALL OR ENDWALL	
	GRATE INLET	
	CURB INLET	
	CLEAN OUT	
E	ELECTRIC MANHOLE	
T	TELEPHONE MANHOLE	
EB	ELECTRIC BOX	
EP	ELECTRIC PEDESTAL	
	MONITORING WELL	
	TEST PIT	
	BENCHMARK	
	BORING	

STANDARD ABBREVIATIONS

FOR ENTIRE PLAN SET

AC	ACRES
ADA	AMERICANS WITH DISABILITY ACT
ARCH	ARCHITECTURAL
BC	BOTTOM OF CURB
BF	BASEMENT FLOOR
BK	BLOCK
BL	BASELINE
BLDG	BUILDING
BM	BUILDING BENCHMARK
BRL	BUILDING RESTRICTION LINE
CF	CUBIC FEET
CL	CENTERLINE
CMP	CORRUGATED METAL PIPE
CONN	CONNECTION
CONC	CONCRETE
CPP	CORRUGATED PLASTIC PIPE
CY	CUBIC YARDS
DEC	DECORATIVE
DEP	DEPRESSED
DIP	DUCTILE IRON PIPE
DOM	DOMESTIC
ELEC	ELECTRIC
ELEV	ELEVATION
EP	EDGE OF PAVEMENT
ES	EDGE OF SHOULDER
EW	END WALL
EX	EXISTING
FES	FLARED END SECTION
FF	FINISHED FLOOR
FH	FIRE HYDRANT
FG	FINISHED GRADE
G	GRADE
GF	GARAGE FLOOR (AT DOOR)
GH	GRADE HIGHER SIDE OF WALL
GL	GRADE LOWER SIDE OF WALL
GRT	GRATE
GV	GATE VALVE
HDPE	HIGH DENSITY POLYETHYLENE PIPE
HP	HIGH POINT
HOR	HORIZONTAL
HW	HEADWALL
INT	INTERSECTION
INV	INVERT
LF	LINEAR FOOT
LOC	LIMITS OF CLEARING
LOD	LIMITS OF DISTURBANCE
LOS	LINE OF SIGHT
LP	LOW POINT
L/S	LANDSCAPE
MAX	MAXIMUM
MIN	MINIMUM
MH	MANHOLE
MJ	MECHANICAL JOINT
OC	ON CENTER
PA	POINT OF ANALYSIS
PC	POINT CURVATURE
PCCR	POINT OF COMPOUND CURVATURE, CURB RETURN
PI	POINT OF INTERSECTION
POG	POINT OF GRADE
PROP	PROPOSED
PT	POINT OF TANGENCY
PTCR	POINT OF TANGENCY, CURB RETURN
PVC	POLYVINYL CHLORIDE PIPE
PVI	POINT OF VERTICAL INTERSECTION
PVT	POINT OF VERTICAL TANGENCY
R	RADIUS
RCP	REINFORCED CONCRETE PIPE
RET WALL	RETAINING WALL
R/W	RIGHT OF WAY
S	SLOPE
SAN	SANITARY SEWER
SF	SQUARE FEET
STA	STATION
STM	STORM
S/W	SIDEWALK
TBR	TO BE REMOVED
TBRL	TO BE RELOCATED
TC	TOP OF CURB
TELE	TELEPHONE
TPF	TREE PROTECTION FENCE
TW	TOP OF WALL
TYP	TYPICAL
UG	UNDERGROUND
UP	UTILITY POLE
W	WIDE
W/L	WATER LINE
W/M	WATER METER
±	PLUS OR MINUS
°	DEGREE
Ø	DIAMETER
#	NUMBER

REVISED: 10/15/2019

VDOT GENERAL NOTES

1. THESE PLANS WERE PREPARED IN ACCORDANCE WITH THE REQUIREMENTS OF (SELECT ONE):
   - VDOT SECONDARY STREET ACCEPTANCE REQUIREMENTS (SSAR 24VAC-30-92 EFFECTIVE FEBRUARY 1, 2012 AND VDOT ROAD DESIGN MANUAL APPENDIX B1).
   - VDOT SECONDARY STREET ACCEPTANCE REQUIREMENTS (SSAR 24VAC-30-92 EFFECTIVE FEBRUARY 1, 2012 AND VDOT ROAD DESIGN MANUAL APPENDIX B2 AS APPROVED FOR USE IN DESIGNATED HIGH DENSITY DEVELOPMENT AREAS).
   - VDOT ROAD DESIGN MANUAL APPENDIX C, RURAL AND URBAN GEOMETRIC DESIGN STANDARDS EFFECTIVE AT THE TIME OF VDOT RECOMMENDED PLAN APPROVAL; LIST STANDARD USED: GS-_____.
2. VDOT APPROVED EXCEPTIONS/WAIVERS (MUST BE INCORPORATED IN THE PLAN):
   - ACCESS MANAGEMENT - DATE OF APPROVAL: _____
   - SSAR- DATE OF APPROVAL: _____
   - DESIGN WAIVER - DATE OF APPROVAL: _____
   - OTHER_____ DATE OF APPROVAL: _____
3. SSAR CONNECTIVITY SUMMARY (PROVIDE A CHECK MARK ✓ WHERE APPLICABLE OR WRITE N/A):
   - CONNECTIONS IN MULTIPLE DIRECTIONS (FIRST CONNECTION MUST BE TO A VDOT MAINTAINED ROAD, THE SECOND CONNECTION MAY EITHER BE TO A VDOT ROAD OR TO A STUB OUT)
   - STUB OUT CONNECTION (THE PROP. RIGHT OF WAY TERMINATES AT PARCEL ABUTTING THE DEVELOPMENT AND CONSISTS OF A SHORT SEGMENT THAT IS INTENDED TO SERVE CURRENT AND FUTURE DEVELOPMENT; THE APPLICANT MUST VERIFY THAT CONNECTION WITH A FUTURE STREET IS FEASIBLE)
   - NETWORK ADDITIONS PROVIDING DIRECT ACCESS TO (I) MORE THAN 200 DWELLING UNITS OR (II) LOTS WHOSE TRIP GENERATION IS EXPECTED TO BE OVER 2,000 VPD MAY BE ACCEPTED INTO THE SECONDARY SYSTEM OF STATE HIGHWAYS IF THE NETWORK ADDITION PROVIDES AN ADDITIONAL EXTERNAL CONNECTION BEYOND THAT REFERENCED ABOVE.
4. ALL WORK ON THIS PROJECT SHALL CONFORM TO THE CURRENT EDITIONS OF AND LATEST REVISIONS TO THE VIRGINIA DEPARTMENT OF TRANSPORTATION (VDOT) ROAD AND BRIDGE SPECIFICATIONS AND STANDARDS, THE VIRGINIA EROSION AND SEDIMENT CONTROL REGULATIONS, AND ANY OTHER APPLICABLE STATE, FEDERAL OR LOCAL REGULATIONS. IN CASE OF A DISCREPANCY OR CONFLICT BETWEEN THE STANDARDS OR SPECIFICATIONS AND REGULATIONS, THE MOST STRINGENT SHALL GOVERN.
5. ALL RIGHT OF WAY DEDICATED TO PUBLIC USE SHALL BE CLEAR AND UNENCUMBERED.
6. ALL UTILITIES, INCLUDING ALL POLES, ARE TO BE RELOCATED AT THE DEVELOPER'S EXPENSE, PRIOR TO CONSTRUCTION.
7. THE DEVELOPER IS RESPONSIBLE FOR ANY DAMAGE TO EXISTING ROADS AND UTILITIES WHICH OCCUR AS A RESULT OF PROJECT CONSTRUCTION WITHIN OR CONTIGUOUS TO EXISTING RIGHT OF WAY.
8. OPEN CUTTING OF PAVED OR SURFACE TREATED ROADS IS NOT PERMITTED. ALL UTILITIES WHICH WILL BE PLACED UNDER EXISTING STREETS ARE TO BE BORED OR JACKED. ANY EXCEPTIONS, DUE TO EXTENUATING CIRCUMSTANCES, ARE TO BE ADDRESSED AT THE PERMIT STAGE.
9. THE PAVEMENT DESIGN IS BASED ON AN ASSUMED CBR VALUE OF 10 (USE A CBR VALUE OF 6 IN LOUDOUN CO.). SOIL TESTS OF SUBGRADE MUST BE SUBMITTED FOR THE ACTUAL DETERMINATION OF THE REQUIRED THICKNESS OF THE PAVEMENT INCLUDING LAYERS OF ASPHALT AND SUBBASE PRIOR TO SUBBASE PLACEMENT.
10. PAVEMENT DESIGN SHALL BE PROVIDED IN ACCORDANCE WITH THE PAVEMENT DESIGN GUIDE FOR SUBDIVISION AND SECONDARY ROADS IN VIRGINIA. FOR PRIMARY ROADS AND INTERSTATE HIGHWAYS WHERE TRUCK TRAFFIC EXCEEDS 5%, PAVEMENT DESIGN SHALL BE PROVIDED IN ACCORDANCE WITH AASHTO GUIDELINES. TYPICAL PAVEMENT SECTIONS SHALL DEPICT THE TOP 6" OF THE SUBGRADE IMMEDIATELY UNDER THE PAVEMENT STRUCTURE COMPACTED TO 100% OF THE THEORETICAL MAXIMUM DRY DENSITY.
11. ALL UNTREATED AGGREGATE USED IN BASE OR SUBBASE COURSES SHALL BE 21B, EXCEPT ON ROADS WITH AN ADT OF 1000 VPD OR LESS, WHERE 21A AGGREGATE MAY BE USED. WHEN 21B AGGREGATE IS USED, UD-4 UNDERDRAINS MUST BE PROVIDED.
12. A 4" (MIN.) LAYER OF STONE IS REQUIRED BENEATH CURB AND GUTTER (MAY BE SHOWN ON TYPICAL SECTION IN LIEU OF A NOTE).
13. THE ENTIRE SURFACE OF THE ROADWAY (OLD AND NEW PORTIONS) SHALL BE OVERLAID AND RE-STRIPED AS REQUIRED BY VDOT PERSONNEL. OVERLAY OF EXISTING PAVEMENT SHALL BE A MINIMUM OF 1.25" DEPTH; ANY COSTS ASSOCIATED WITH PAVEMENT OVERLAY, OR THE MILLING OF EXISTING PAVEMENT TO OBTAIN REQUIRED DEPTH, SHALL BE ASSUMED BY THE DEVELOPER.
14. A SMOOTH GRADE SHALL BE MAINTAINED FROM THE CENTERLINE OF THE EXISTING ROAD TO THE PROPOSED EDGE OF PAVEMENT TO PRECLUDE THE FORMING OF FALSE GUTTERS AND/OR THE PONDING OF ANY WATER IN THE ROADWAY.
15. ASPHALT PAVEMENT WIDENING SHALL CONFORM TO VDOT STANDARD WP-2.
16. ANY TYPE OF REVERSE CURB (SPILL CURB, CG-6R, ETC.) AND TRANSITION TO THESE CURBS SHALL NOT BE USED WITHIN THE PUBLIC RIGHT OF WAY.
17. THE COUNTY/TOWN SHALL OBTAIN A PERMIT FOR ALL SIDEWALKS/CROSSWALKS WITHIN THE RIGHT OF WAY THAT DO NOT QUALIFY FOR VDOT MAINTENANCE.
18. ADDITIONAL DITCH LININGS OR SILTATION AND EROSION CONTROL MEASURES SHALL BE PROVIDED, AT THE DEVELOPER'S EXPENSE, AS DETERMINED NECESSARY BY VDOT AND/OR THE COUNTY/TOWN DURING FIELD REVIEW. ALL COSTS SHALL BE ASSUMED BY THE DEVELOPER.
19. STANDARD GUARDRAILS AND/OR HANDRAILS SHALL BE INSTALLED AT HAZARDOUS LOCATIONS AS DESIGNATED DURING FIELD REVIEW BY THE COUNTY/TOWN INSPECTOR OR VDOT.
20. A LANDSCAPING AND IRRIGATION SYSTEMS PLAN SHALL BE SUBMITTED FOR VDOT APPROVAL PRIOR TO INSTALLING ANY LANDSCAPING AND IRRIGATION SYSTEMS WITHIN THE PUBLIC RIGHT OF WAY.
21. FLOWERS, SHRUBS, TREES, AND IRRIGATION SHALL NOT BE PLACED WITHIN STATE MAINTAINED RIGHT OF WAY LIMITS WITHOUT AN APPROVED SET OF PLANS AND AN APPROVED PLANTING AGREEMENT. NO IRRIGATION (SPRINKLER) SYSTEMS, BRICK COLUMNS, END WALLS, AND/OR BRICK MAILBOXES WILL BE CONSTRUCTED OR INSTALLED WITHIN STATE MAINTAINED RIGHT OF WAY LIMITS WITHOUT A PERMIT. ANY OF THE ABOVE ITEMS FOUND IN THE RIGHT OF WAY WITHOUT A PERMIT WILL BE REMOVED, AND ALL COSTS OF THE REMOVAL WILL BE BORNE BY THE OWNER AND/OR DEVELOPER.
22. TRAFFIC CONTROL DEVICES OR ADVISORY SIGNS, SUCH AS MULTIWAY STOPS, SPEED LIMITS, WATCH FOR CHILDREN, PEDESTRIAN TRAFFIC ETC., SHALL NOT BE INSTALLED UNLESS SPECIFICALLY APPROVED BY VDOT TRAFFIC ENGINEERING SECTION. SHOULD UNAPPROVED SIGNS BE NOTED AT THE TIME OF VDOT INSPECTION, THE ROAD ACCEPTANCE PROCESS SHALL BE TERMINATED IMMEDIATELY AND NOT RECOMMENCED UNTIL A DETERMINATION IS MADE REGARDING THE APPROVAL OF ANY ADDITIONAL SIGNS. IMMEDIATE REMOVAL OF SUCH SIGNS SHALL NOT NEGATE THE NEED FOR THE SUBMISSION OF A REVISION.
23. A SPEED STUDY CERTIFIED BY A PROFESSIONAL ENGINEER SHALL BE SUBMITTED FOR VDOT APPROVAL PRIOR TO THE STREET ACCEPTANCE FOR ANY ROAD TO BE POSTED OTHER THAN THE STATUTORY SPEED LIMIT.
24. THE DEVELOPER IS RESPONSIBLE FOR ALL TRAFFIC CONTROL. THE DEVELOPER SHALL SUBMIT A SIGNING, STRIPING AND/OR SIGNALIZATION PLAN TO THE VDOT LAND DEVELOPMENT SECTION PRIOR TO PERMIT APPLICATION. THE DEVELOPER SHALL NOT COMMENCE CONSTRUCTION OF ANY PAVEMENT COURSE WITHOUT AN APPROVED STRIPING PLAN.
25. THE DEVELOPER IS RESPONSIBLE FOR THE DESIGN AND CONSTRUCTION OF ANY TRAFFIC SIGNAL INSTALLATION OR MODIFICATION WHICH WILL BE NECESSARY AS A RESULT OF THE DEVELOPMENT OF THIS SITE.
26. DURING CONSTRUCTION, THE MAINTENANCE OF TRAFFIC SHALL CONFORM TO THE REQUIREMENTS IN THE MOST RECENT VERSION OF THE VIRGINIA WORK AREA PROTECTION MANUAL AND THE MUTCD.

PROPOSED EASEMENT LEGEND

SL (DIM)	SIGHT DISTANCE
STM (DIM)	STORM DRAIN
SS (DIM)	SANITARY SEWER
W (DIM)	WATER
PA (DIM)	PUBLIC ACCESS
CSE (DIM)	COMMON SHARED
IE (DIM)	INGRESS-EGRESS
PU (DIM)	PUBLIC UTILITY
VAR	VARIABLE WIDTH S

BOHLER
SITE CIVIL AND CONSULTING ENGINEERING
LAND SURVEYING
PROGRAM MANAGEMENT
LANDSCAPE ARCHITECTURE
CONSTRUCTION MANAGEMENT
PERMITTING SERVICES
TRANSPORTATION PLANNING

THE INFORMATION, DESIGN AND CONCEPTS OF THIS PLAN ARE PROPRIETARY AND SHALL NOT BE COPIED OR USED FOR ANY PURPOSE WITHOUT PRIOR WRITTEN AUTHORIZATION FROM BOHLER. ONLY APPROVED AND SEALED PLANS SHALL BE UTILIZED FOR CONSTRUCTION PURPOSES.
© BOHLER

REVISIONS

REV	DATE	COMMENT	DRAWN BY / CHECKED BY

811 Know what's below. Call before you dig.
ALWAYS CALL 811
It's fast. It's free. It's the law.

NOT APPROVED FOR CONSTRUCTION

THIS DRAWING IS INTENDED FOR MUNICIPAL AND/OR AGENCY REVIEW AND APPROVAL. IT IS NOT INTENDED AS A CONSTRUCTION DOCUMENT UNLESS INDICATED OTHERWISE.

PROJECT No.:	V194600
DRAWN BY:	EEN
CHECKED BY:	RTY
DATE:	03/18/2020
CAD I.D.:	1

PROJECT:

MAJOR SITE PLAN AMENDMENT

FOR

29TH PLACE DRIVE THRU

LOCATION

1500 SEMINOLE TRAIL
CHARLOTTESVILLE, VA 22901
ALBEMARLE COUNTY

BOHLER
28 BLACKWELL PARK LANE, SUITE 201
WARRENTON, VIRGINIA 20186
Phone: (540) 349-4500
Fax: (540) 349-0321
VA@BohlerEng.com

COMMONWEALTH OF VIRGINIA
RYAN YAUGER
Lic. No. 0402056625
6/18/2020
PROFESSIONAL ENGINEER

SHEET TITLE:

GENERAL NOTES AND LEGEND

SHEET NUMBER:

C-102

REVISION 1 - 6/18/2020

N:\PM\V194600\DRAWINGS\04_SITE\SHEETS\MAJOR SITE\V194600-SITE-3-1-----3-4.DWG 6/17/2020 11:08:58 AM EDT EEN

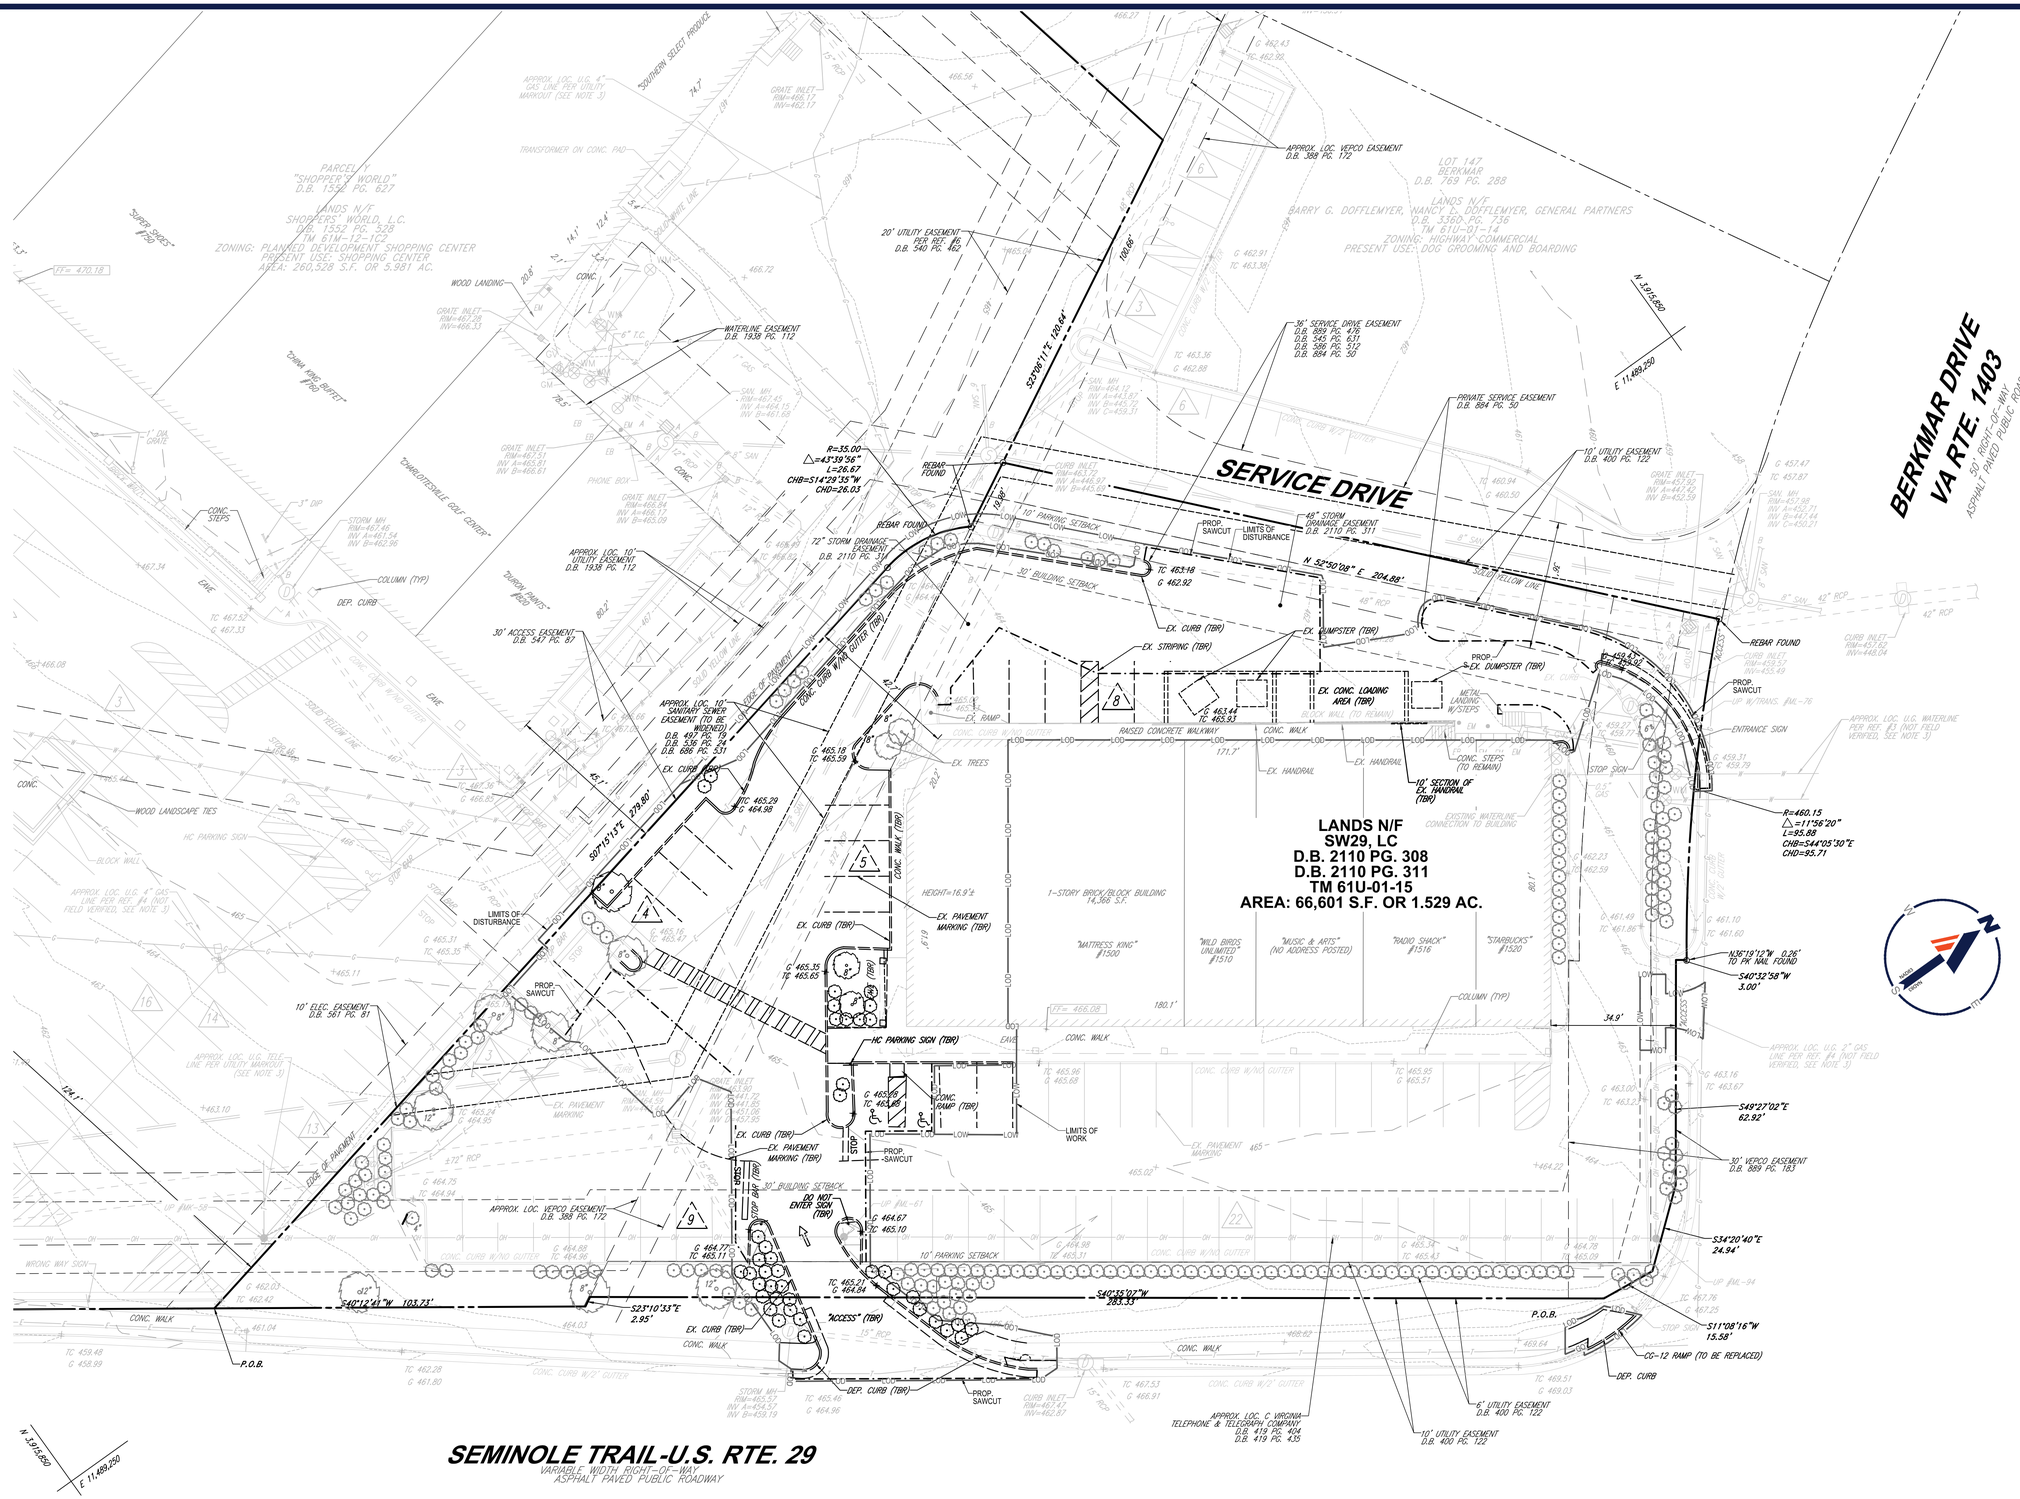

BOHLER

SITE CIVIL AND CONSULTING ENGINEERING
LAND DEVELOPMENT
PROGRAM MANAGEMENT
LANDSCAPE ARCHITECTURE
SUSTAINABLE DESIGN
PERMITTING SERVICES
TRANSPORTATION SERVICES

THE INFORMATION, DESIGN AND CONCEPTS OF THIS PLAN ARE PROPRIETARY AND SHALL NOT BE USED OR DISCLOSED FOR ANY PURPOSE WITHOUT PRIOR WRITTEN AUTHORIZATION FROM BOHLER. © BOHLER

REVISIONS

REV	DATE	COMMENT	DRAWN BY / CHECKED BY

811 Know what's below. Call before you dig.

ALWAYS CALL 811

It's fast. It's free. It's the law.

NOT APPROVED FOR CONSTRUCTION

THIS DRAWING IS INTENDED FOR MUNICIPAL AND/OR AGENCY REVIEW AND APPROVAL. IT IS NOT INTENDED AS A CONSTRUCTION DOCUMENT UNLESS INDICATED OTHERWISE.

PROJECT No.:	V194600
DRAWN BY:	EEN
CHECKED BY:	RTY
DATE:	03/18/2020
CAD I.D.:	1

PROJECT:

MAJOR SITE PLAN AMENDMENT

FOR

29TH PLACE DRIVE THRU

LOCATION

1500 SEMINOLE TRAIL
CHARLOTTESVILLE, VA 22901
ALBEMARLE COUNTY

BOHLER
28 BLACKWELL PARK LANE, SUITE 201
WARRENTON, VIRGINIA 20186
Phone: (540) 349-4500
Fax: (540) 349-0321
VA@BohlerEng.com

COMMONWEALTH OF VIRGINIA
RYAN YAUGER
Lic. No. 0402056625
6/18/2020
PROFESSIONAL ENGINEER

SHEET TITLE:

EXISTING CONDITIONS & DEMOLITION PLAN

SHEET NUMBER:

C-202

REVISION 1 - 6/18/2020

H:\0V194600\DRAWINGS\SITE_PLAN\SITE\MAJOR SITE\V194600-SSP-A-----A1 XNOTE C-202 - DEMO

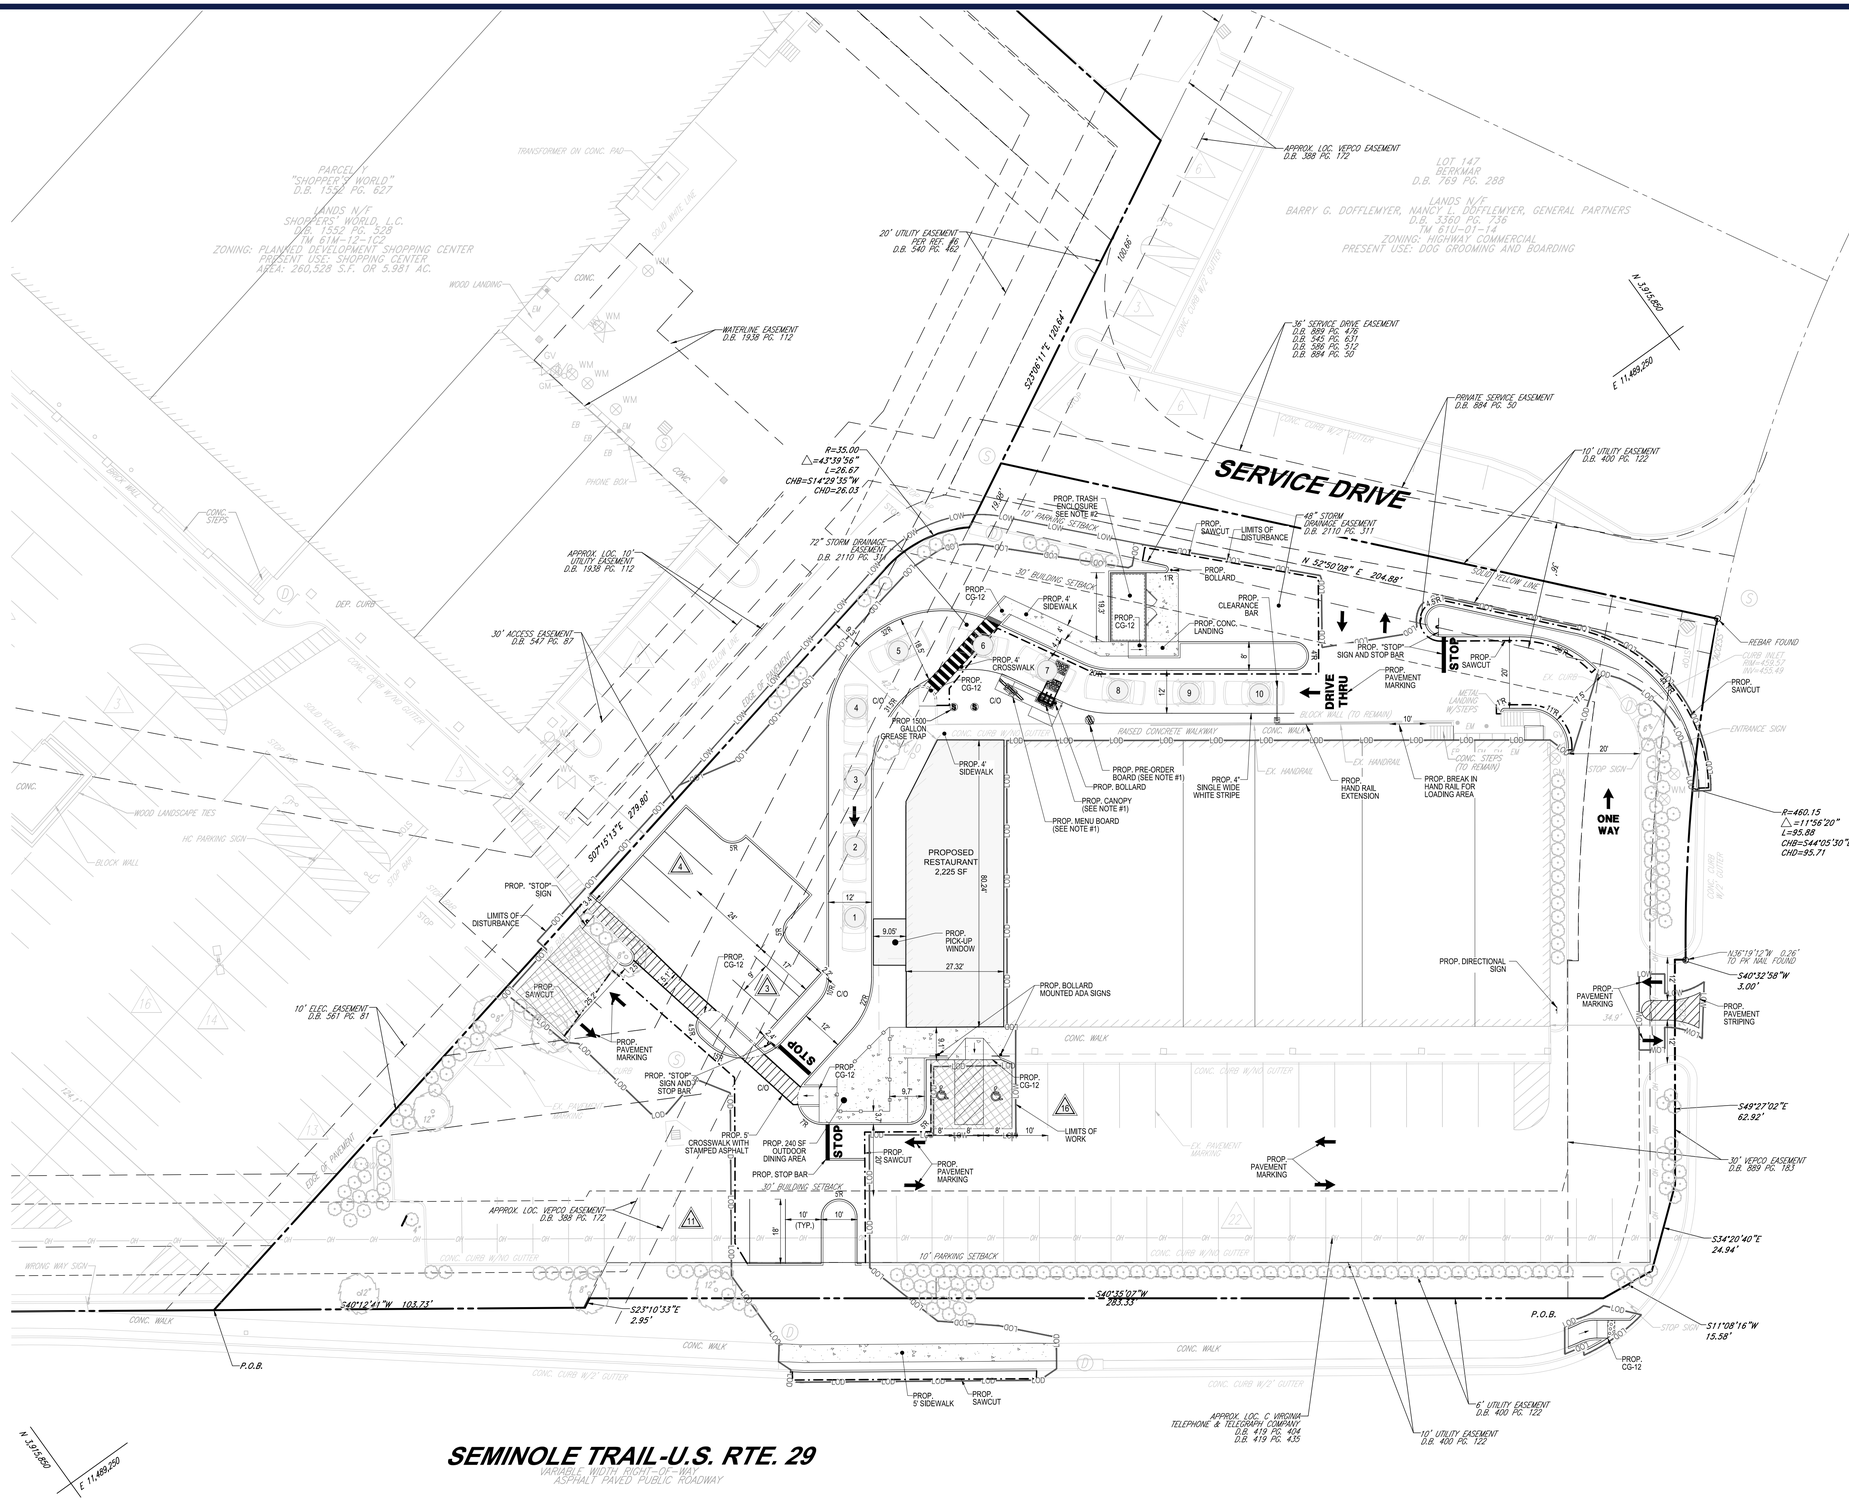

NOTES:

1. PLEASE REFER TO ARCHITECTURAL PLAN FOR DRIVE-THRU FEATURE DETAILS.
2. CONTRACTOR TO ENSURE THAT THE FENCE AROUND THE DUMPSTER AREA COMPLIES WITH ALBEMARLE COUNTY CODE. DUMPSTERS, OUTDOOR TRASH RECEPTACLES, AND OTHER, SIMILAR OUTDOOR REFUSE CONTAINERS SHALL BE SCREENED WITH AN ENCLOSURE AT A MINIMUM HEIGHT OF ONE (1) FOOT ABOVE THE HEIGHT OF THE DUMPSTER WITH A MINIMUM INSIDE CLEARANCE AT THE OPENING OF TWELVE (12) FEET.
3. FOR WORK ALONG THE RIGHT-OF-WAY, PLEASE REFER TO SHEET C-803 FOR THE MAINTENANCE OF TRAFFIC PLAN.

LEGEND:

MILL AND OVERLAY AREA

SITE TABULATIONS:

PARCEL ID: 061U0-01-00-01500

TOTAL PARCEL AREA: 1.53 AC

ZONING: PLANNED DEVELOPMENT SHOPPING CENTER

ZMA2001-14 WITH ASSOCIATED PROFFERS

EXISTING USE: COMMERCIAL / RETAIL

PROPOSED USE: RESTAURANT WITH DRIVE THRU

PARKING:

EXISTING GROSS LEASABLE FLOOR AREA FOR ENTIRE 29TH PLACE SHOPPING CENTER: 169,649 SF

EXISTING SPACES REQUIRED: 169,649 SF X (4.75 SPACES /1,000 SF GFA) =806 SPACES

EXISTING SPACES: 815

PROPOSED LEASABLE FLOOR AREA: 169,766 SF

PARKING REQUIRED: 169,766 SF X (4.75 SPACES /1,000 SF GFA) =806 SPACES

TOTAL SPACES PROVIDED: 807

20 10 5 0 20

1"= 20'

BOHLER™

SITE CIVIL AND CONSULTING ENGINEERING
LAND SURVEYING
PROGRAM MANAGEMENT
LANDSCAPE ARCHITECTURE
SUSTAINABLE DESIGN
PERMITTING SERVICES
TRANSPORTATION SERVICES

THE INFORMATION, SUBCONCEPTS OF THIS PLAN ARE PROPRIETARY AND SHALL NOT BE USED OR DISCLOSED FOR ANY PURPOSE WITHOUT THE WRITTEN CONSENT OF BOHLER. © BOHLER

REVISIONS

REV	DATE	COMMENT	DRAWN BY / CHECKED BY

811 Know what's below. Call before you dig.

ALWAYS CALL 811
It's fast. It's free. It's the law.

NOT APPROVED FOR CONSTRUCTION

THIS DRAWING IS INTENDED FOR MUNICIPAL AND/OR AGENCY REVIEW AND APPROVAL. IT IS NOT INTENDED AS A CONSTRUCTION DOCUMENT UNLESS INDICATED OTHERWISE.

PROJECT No.:	V194600
DRAWN BY:	EEN
CHECKED BY:	RTY
DATE:	03/18/2020
CAD I.D.:	1

PROJECT:

MAJOR SITE PLAN AMENDMENT

FOR

29TH PLACE DRIVE THRU

LOCATION

1500 SEMINOLE TRAIL
CHARLOTTESVILLE, VA 22901
ALBEMARLE COUNTY

BOHLER

28 BLACKWELL PARK LANE, SUITE 201
WARRENTON, VIRGINIA 20186
Phone: (540) 349-4500
Fax: (540) 349-0321
VA@BohlerEng.com

COMMONWEALTH OF VIRGINIA
RYAN YAUGER
Lic. No. 0402056625
6/18/2020
PROFESSIONAL ENGINEER

SHEET TITLE:

SITE PLAN

SHEET NUMBER:

C-301

REVISION 1 - 6/18/2020

H:\BOHLER\DRAWINGS\SITE PLAN-SETS\MAJOR SP AVI\194600-SSP-A——A LAYOUT C-301 - SITE

DATE PLOTTED: 6/18/2020

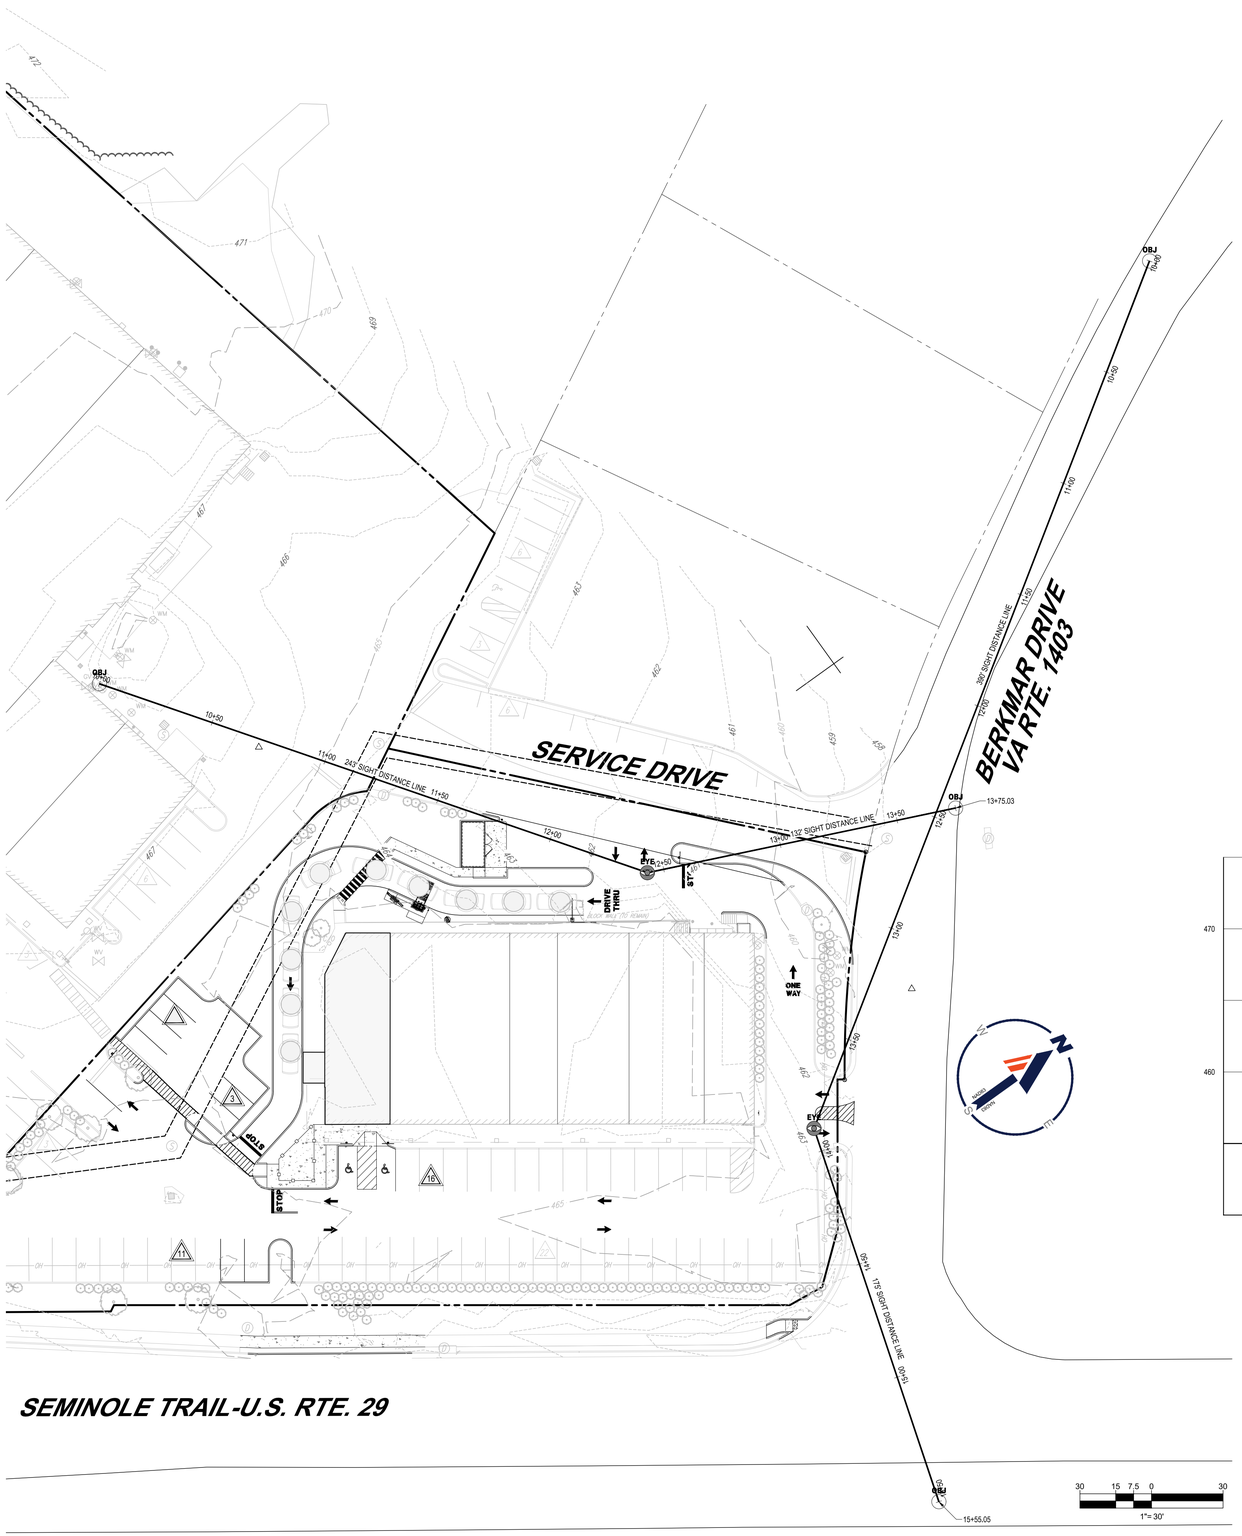

SEMINOLE TRAIL-U.S. RTE. 29

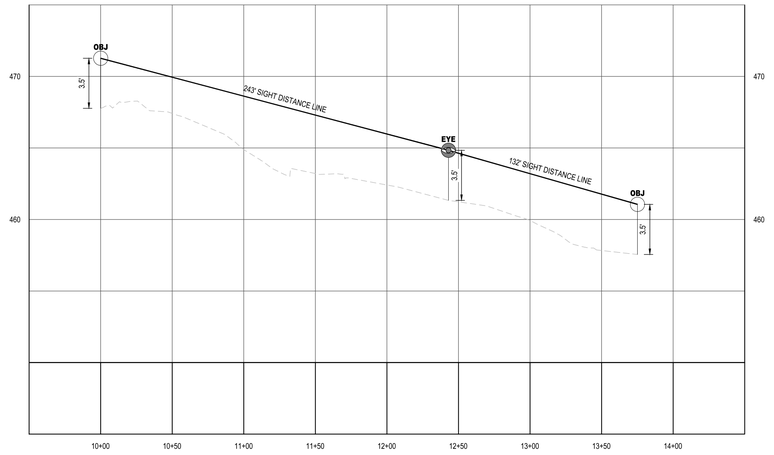

SERVICE DRIVE SIGHT DISTANCE PROFILE

SCALE: 1"= 50 ' HORIZONTAL
1"= 5 ' VERTICAL

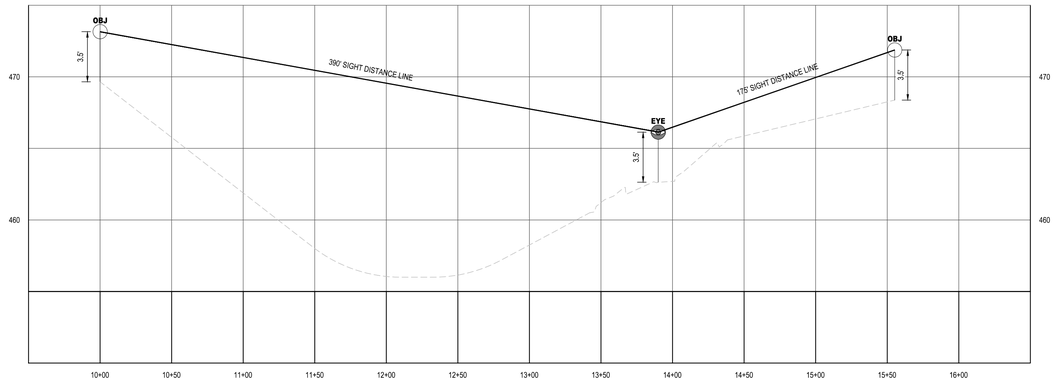

BERKMAR DRIVE SIGHT DISTANCE PROFILE

SCALE: 1"= 50 ' HORIZONTAL
1"= 5 ' VERTICAL

NOTES:

1. LANDSCAPING PLANTS AND TREES ADJACENT TO THE SIGHT DISTANCE TRIANGLE WILL NEED TO BE MAINTAINED IN AREA BETWEEN 2 AND 7 FEET ABOVE GROUND AS A CLEAR ZONE TO PRESERVE SIGHT LINES AND ACCOMMODATE PEDESTRIANS.

BOHLER™

SITE CIVIL AND CONSULTING ENGINEERING
LAND SURVEYING
PROGRAM MANAGEMENT
LANDSCAPE ARCHITECTURE
SUSTAINABLE DESIGN
PERMITTING SERVICES
TRANSPORTATION SERVICES

THE INFORMATION, DESIGN AND CONCEPTS OF THIS PLAN ARE PROPRIETARY AND SHALL NOT BE USED OR DISCLOSED WITHOUT PRIOR WRITTEN AUTHORIZATION FROM BOHLER. ALL RIGHTS RESERVED. COPYRIGHT © BOHLER

REVISIONS

REV	DATE	COMMENT	DRAWN BY / CHECKED BY

811 Know what's below. Call before you dig.
ALWAYS CALL 811
It's fast. It's free. It's the law.

NOT APPROVED FOR CONSTRUCTION

THIS DRAWING IS INTENDED FOR MUNICIPAL AND/OR AGENCY REVIEW AND APPROVAL. IT IS NOT INTENDED AS A CONSTRUCTION DOCUMENT UNLESS INDICATED OTHERWISE.

PROJECT No.:	V194600
DRAWN BY:	EEN
CHECKED BY:	RTY
DATE:	03/18/2020
CAD I.D.:	1

PROJECT:

MAJOR SITE PLAN AMENDMENT

FOR

29TH PLACE DRIVE THRU

LOCATION

1500 SEMINOLE TRAIL
CHARLOTTESVILLE, VA 22901
ALBEMARLE COUNTY

BOHLER

28 BLACKWELL PARK LANE, SUITE 201
WARRENTON, VIRGINIA 20186
Phone: (540) 349-4500
Fax: (540) 349-0321
VA@BohlerEng.com

COMMONWEALTH OF VIRGINIA
RYAN YAUGER
Lic. No. 0402056625
6/18/2020
PROFESSIONAL ENGINEER

SHEET TITLE:

SIGHT DISTANCE PROFILES

SHEET NUMBER:

C-302

REVISION 1 - 6/18/2020

H:\09\V194600\DRAWINGS\PLAN SETS\MAJOR SPA\V194600-PPR_PA-----A1.AXO.TT.C-302 - SIGHT PROFILES

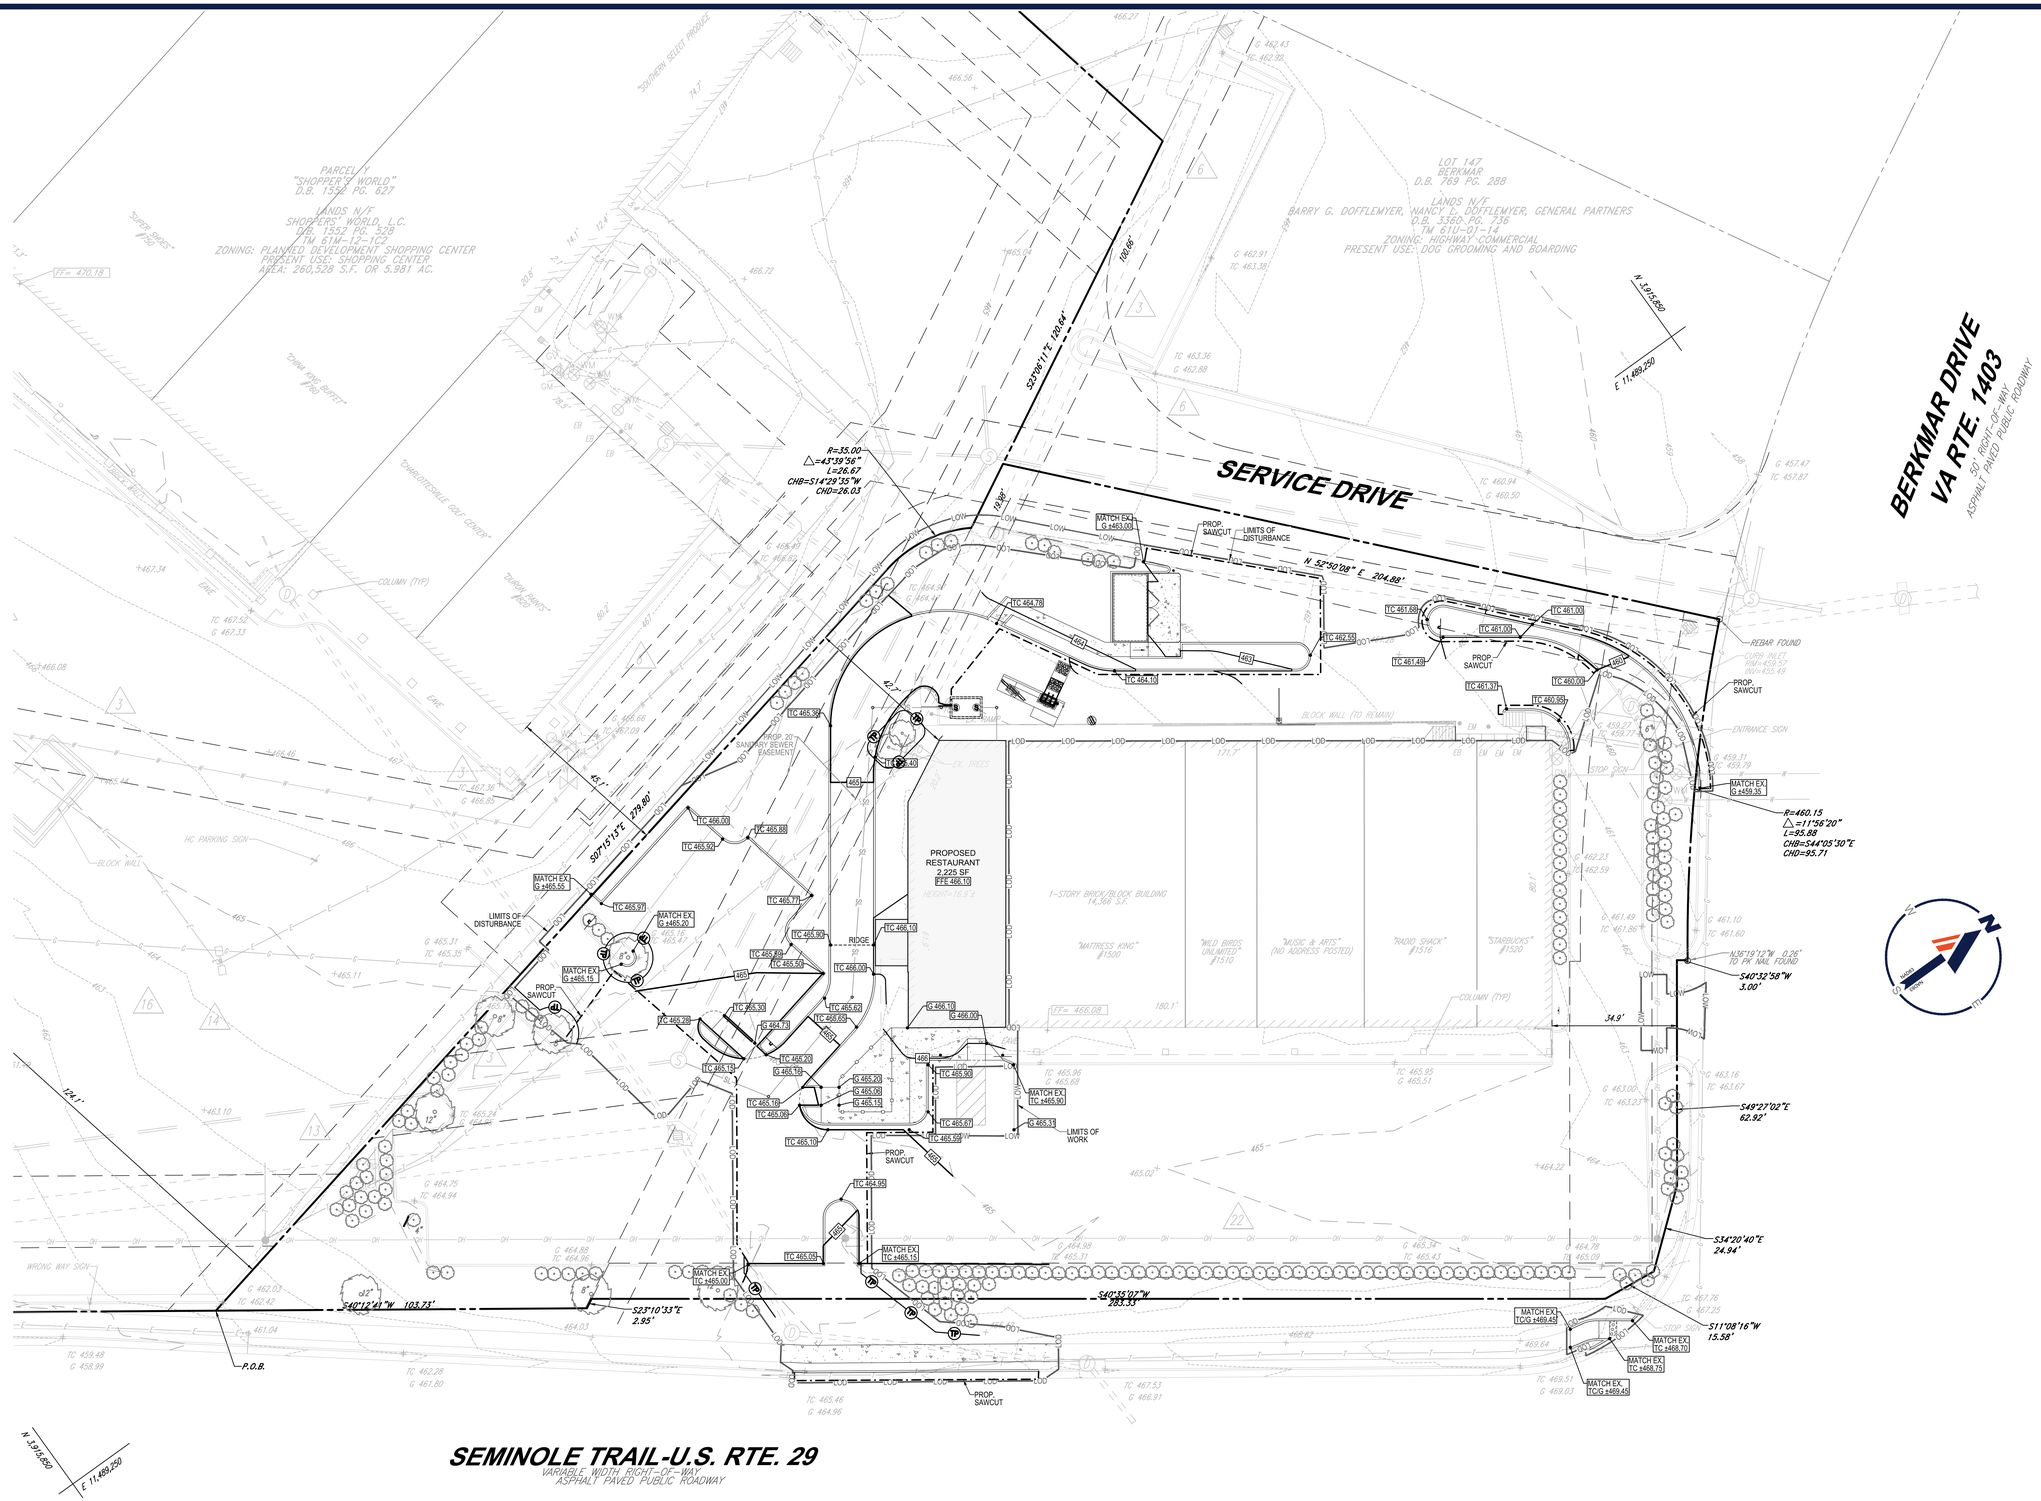

BOHLER™

SITE CIVIL AND CONSULTING ENGINEERING
LAND DEVELOPMENT
PROGRAM MANAGEMENT
LANDSCAPE ARCHITECTURE
SUSTAINABLE DESIGN
PERMITTING SERVICES
TRANSPORTATION SERVICES

THE INFORMATION, SELECTIONS AND OPINIONS CONTAINED IN THESE DRAWINGS ARE THE PROPERTY OF BOHLER AND ARE NOT TO BE USED IN WHOLE OR IN PART FOR ANY PROJECT OTHER THAN THE ONE FOR WHICH THEY ARE SPECIFICALLY PREPARED AND PROCURED WITHOUT THE WRITTEN CONSENT OF BOHLER.

REVISIONS

REV	DATE	COMMENT	DRAWN BY / CHECKED BY

811 Know what's below. Call before you dig.

ALWAYS CALL 811
It's fast. It's free. It's the law.

NOT APPROVED FOR CONSTRUCTION

THIS DRAWING IS INTENDED FOR MUNICIPAL AND/OR AGENCY REVIEW AND APPROVAL. IT IS NOT INTENDED AS A CONSTRUCTION DOCUMENT UNLESS INDICATED OTHERWISE.

PROJECT No.:	V194600
DRAWN BY:	EEN
CHECKED BY:	RTY
DATE:	03/18/2020
CAD I.D.:	1

PROJECT:

MAJOR SITE PLAN AMENDMENT

FOR

29TH PLACE DRIVE THRU

LOCATION

1500 SEMINOLE TRAIL
CHARLOTTESVILLE, VA 22901
ALBEMARLE COUNTY

BOHLER
28 BLACKWELL PARK LANE, SUITE 201
WARRENTON, VIRGINIA 20186
Phone: (540) 349-4500
Fax: (540) 349-0321
VA@BohlerEng.com

COMMONWEALTH OF VIRGINIA
RYAN YAUGER
Lic. No. 0402056625
PROFESSIONAL ENGINEER
6/18/2020

SHEET TITLE:

GRADING PLAN

SHEET NUMBER:

C-401

REVISION 1 - 6/18/2020

PLOT LAYER

IN

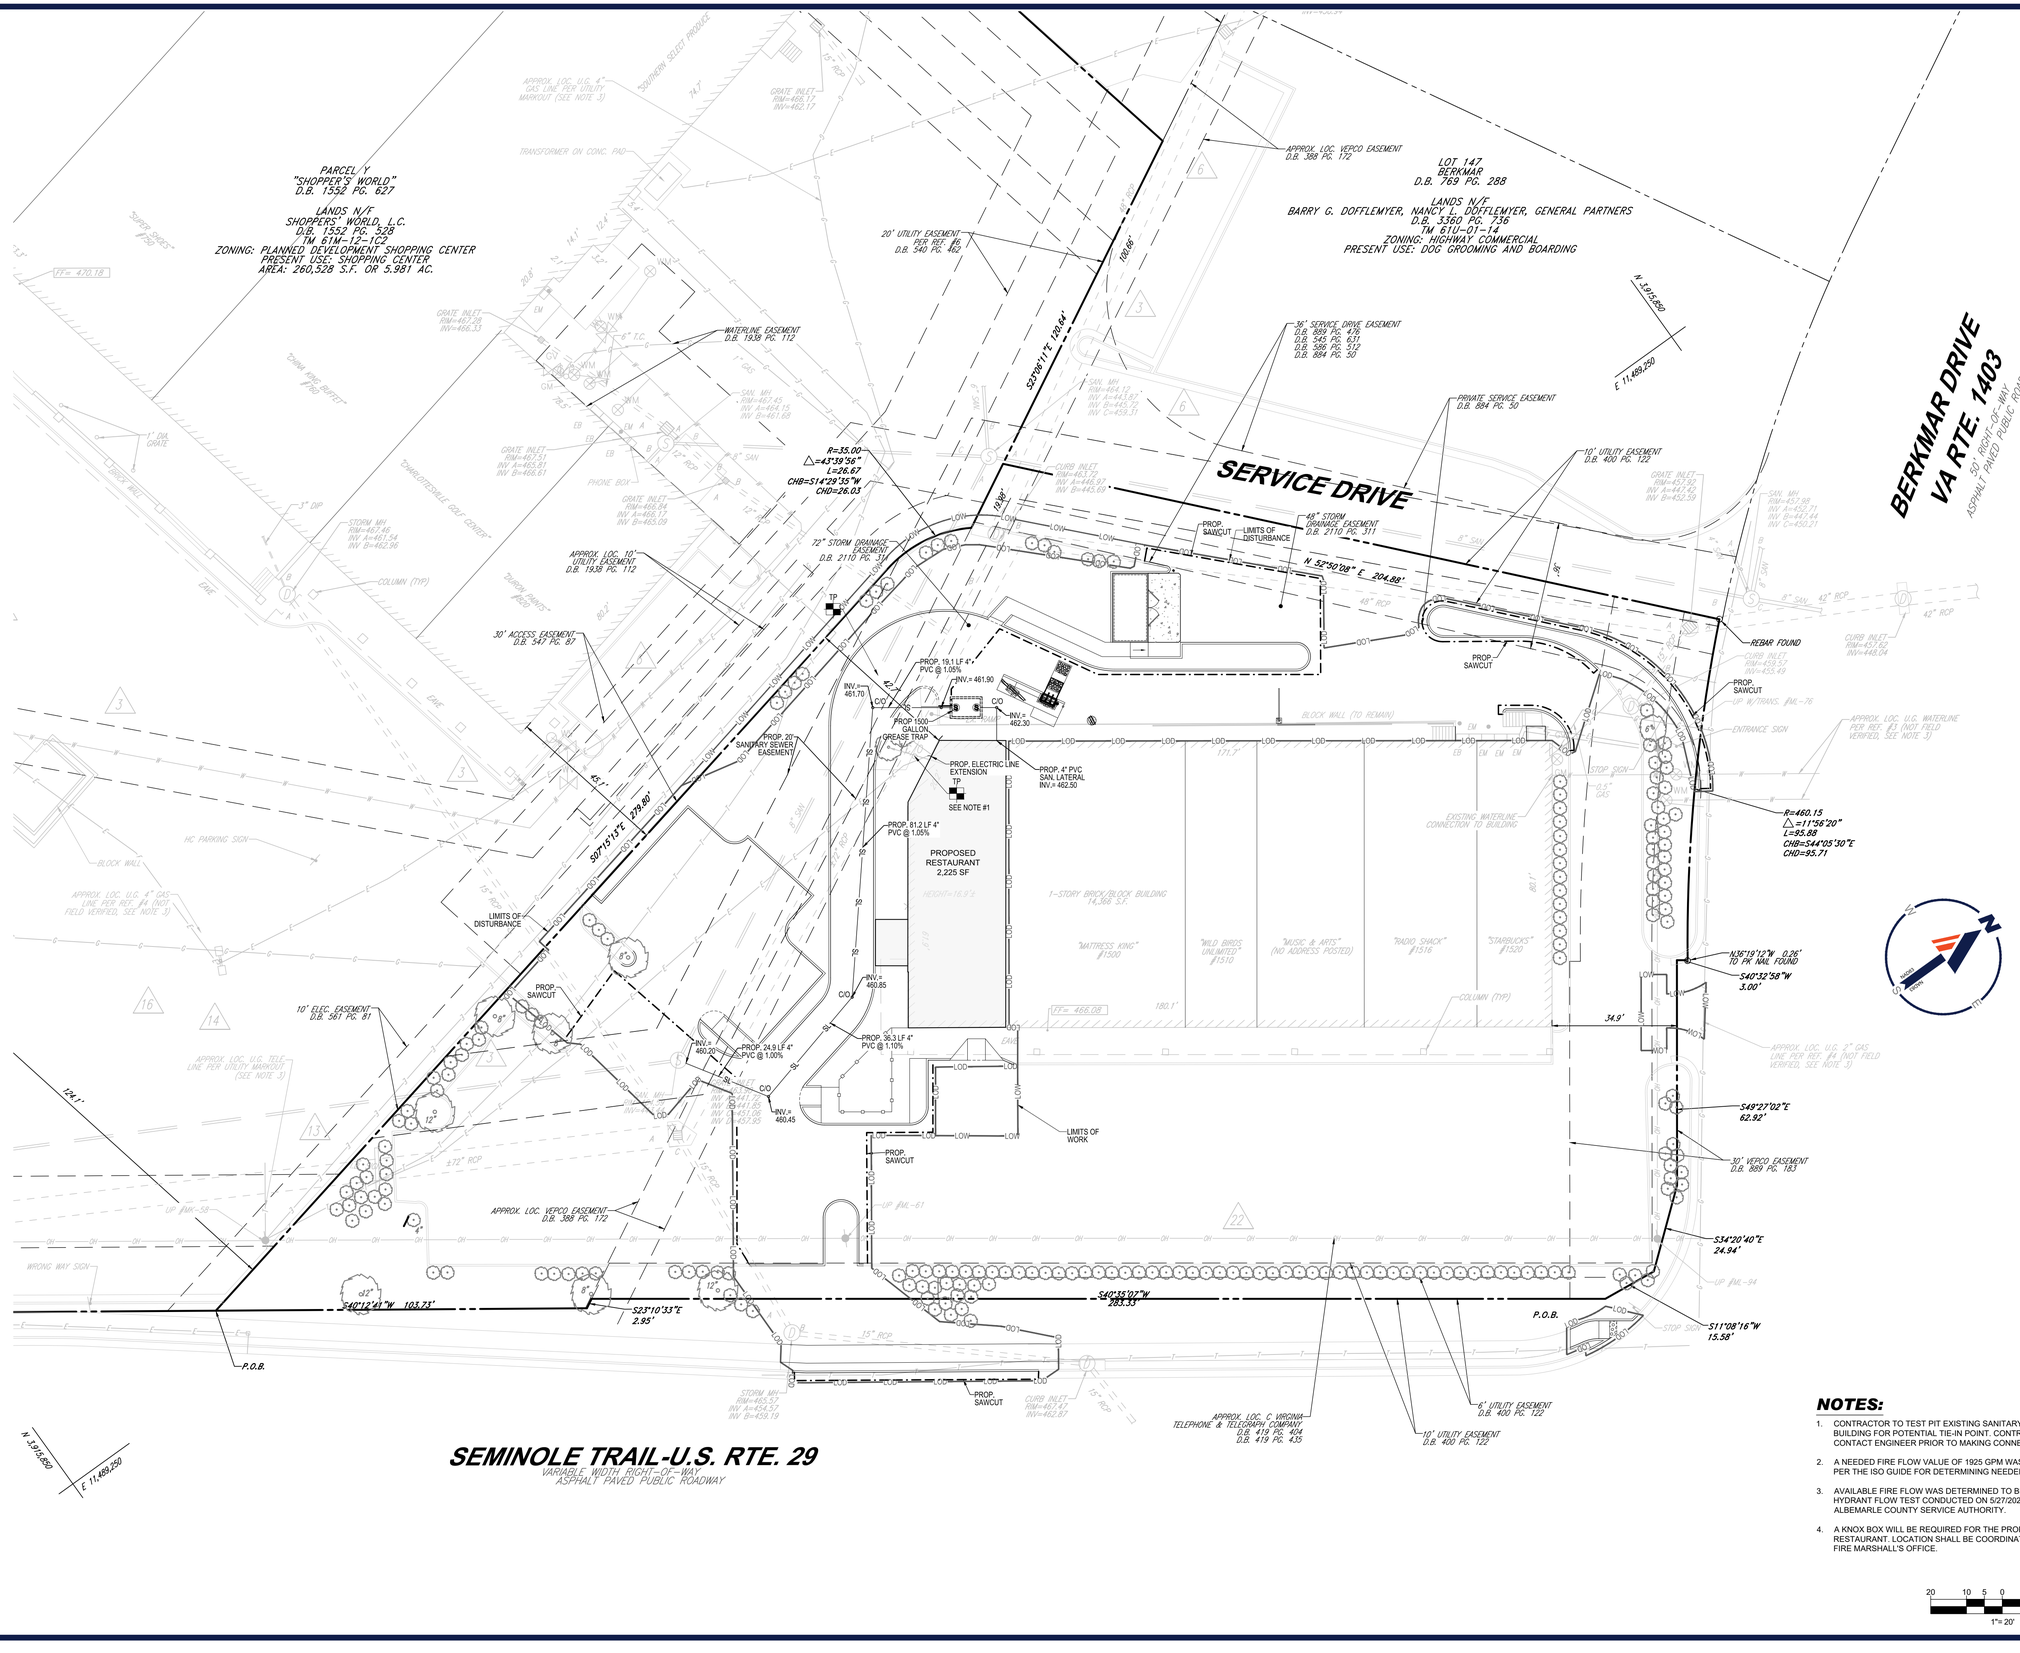
PARCEL Y
"SHOPPER'S WORLD"
D.B. 1552 PG. 627
LANDS N/F
SHOPPERS WORLD, L.C.
D.B. 1552 PG. 628
TM 61M-12-1C2
ZONING: PLANNED DEVELOPMENT SHOPPING CENTER
PRESENT USE: SHOPPING CENTER
AREA: 260,528 S.F. OR 5.981 AC.
LOT 147
BERKMAR
D.B. 769 PG. 288
LANDS N/F
BARRY G. DOFFLEMYER, NANCY L. DOFFLEMYER, GENERAL PARTNERS
D.B. 3380 PG. 736
TM 61U-01-14
ZONING: HIGHWAY COMMERCIAL
PRESENT USE: DOG GROOMING AND BOARDING
BERKMAR DRIVE
VA RTE. 1403
50' RIGHT-OF-WAY
ASPHALT PAVED PUBLIC ROADWAY
SERVICE DRIVE
SEMINOLE TRAIL
U.S. RTE. 29
VARIABLE WIDTH RIGHT-OF-WAY
ASPHALT PAVED PUBLIC ROADWAY
PROPOSED RESTAURANT 2,225 SF
HEIGHT=16.9'±
1-STORY BRICK/BLOCK BUILDING 14,388 S.F.
"MATTRESS KING" #1580
"WILD BIRDS UNLIMITED" #1510
"MUSIC & ARTS" (NO ADDRESS POSTED)
"RADIO SHACK" #1516
"STARBUCKS" #1520
S23°08'11"E 120.84'
N 52°50'08" E 204.89'
S40°12'41"W 103.73'
S23°10'33"E 2.85'
S40°35'07"W 283.33'
S49°27'02"E 62.92'
S34°20'40"E 24.94'
S11°08'16"W 15.58'
N36°19'10"W 0.26'
TO PK NAIL FOUND
S40°32'58"W 3.00'
R=35.00'
Δ=43°39'56"
L=26.67'
CHB=S14°29'35"W
CHD=26.03'
R=460.15'
Δ=11°56'20"
L=95.88'
CHB=S44°05'30"E
CHD=95.71
N 3,916,850
E 11,469,250
P.O.B.
REBAR FOUND
PROP. SAWCUT
LIMITS OF DISTURBANCE
LIMITS OF WORK
PROP. 19.1 LF 4" PVC @ 1.05%
PROP. 1500 GALLON GREASE TRAP
PROP. 20' SANITARY SEWER EASEMENT
PROP. ELECTRIC LINE EXTENSION
PROP. 4" PVC SAN. LATERAL
PROP. 81.2 LF 4" PVC @ 1.05%
PROP. 36.3 LF 4" PVC @ 1.10%
PROP. 24.9 LF 4" PVC @ 1.00%
SEE NOTE #1
72" STORM DRAINAGE EASEMENT D.B. 2110 PG. 311
48" STORM DRAINAGE EASEMENT D.B. 2110 PG. 311
20' UTILITY EASEMENT PER REF. #6 D.B. 540 PG. 462
WATERLINE EASEMENT D.B. 1939 PG. 112
APPROX. LOC. 10' UTILITY EASEMENT D.B. 1938 PG. 112
30' ACCESS EASEMENT D.B. 547 PG. 87
10' ELEC. EASEMENT D.B. 561 PG. 81
APPROX. LOC. VEPCO EASEMENT D.B. 389 PG. 172
30' SERVICE DRIVE EASEMENT D.B. 389 PG. 476 D.B. 545 PG. 611 D.B. 586 PG. 512 D.B. 884 PG. 50
PRIVATE SERVICE EASEMENT D.B. 884 PG. 50
10' UTILITY EASEMENT D.B. 400 PG. 122
6' UTILITY EASEMENT D.B. 400 PG. 122
10' VEPCO EASEMENT D.B. 889 PG. 183
APPROX. LOC. VIRGINIA TELEPHONE & TELEGRAPH COMPANY D.B. 419 PG. 404 D.B. 419 PG. 435
APPROX. LOC. U.G. 4" GAS LINE PER REF. #4 (NOT FIELD VERIFIED, SEE NOTE 3)
APPROX. LOC. U.G. TELE. LINE PER UTILITY MARKOUT (SEE NOTE 3)
APPROX. LOC. U.G. WATERLINE PER REF. #3 (NOT FIELD VERIFIED, SEE NOTE 3)
APPROX. LOC. U.G. 2" GAS LINE PER REF. #4 (NOT FIELD VERIFIED, SEE NOTE 3)
EXISTING WATERLINE CONNECTION TO BUILDING
ENTRANCE SIGN
STOP SIGN
HC PARKING SIGN
WRONG WAY SIGN
BLOCK WALL
BLOCK WALL (TO REMAIN)
COLUMN (TYP.)
STORM MH RIM=467.46 INV A=461.54 INV B=462.96
GRATE INLET RIM=467.53 INV A=465.91 INV B=466.61
GRATE INLET RIM=466.94 INV A=466.12 INV B=465.59
GRATE INLET RIM=466.17 INV=462.17
GRATE INLET RIM=467.36 INV=466.33
SAN. MH RIM=467.45 INV A=464.15 INV B=461.66
SAN. MH RIM=464.13 INV A=443.87 INV B=445.71 INV C=459.31
CURB INLET RIM=463.17 INV A=446.87 INV B=445.69
CURB INLET RIM=457.62 INV=448.04
CURB INLET RIM=459.57 INV=455.49
SAN. MH RIM=457.98 INV A=452.71 INV B=447.44 INV C=453.21
STORM MH RIM=465.57 INV A=454.57 INV B=459.19
CURB INLET RIM=462.87 INV=462.87
TP
TF= 470.18
TF= 466.08
INV.= 461.70
INV.= 461.90
INV.= 462.30
INV.= 460.85
INV.= 460.20
INV.= 460.45
INV.= 461.60
INV.= 461.55
INV.= 457.95

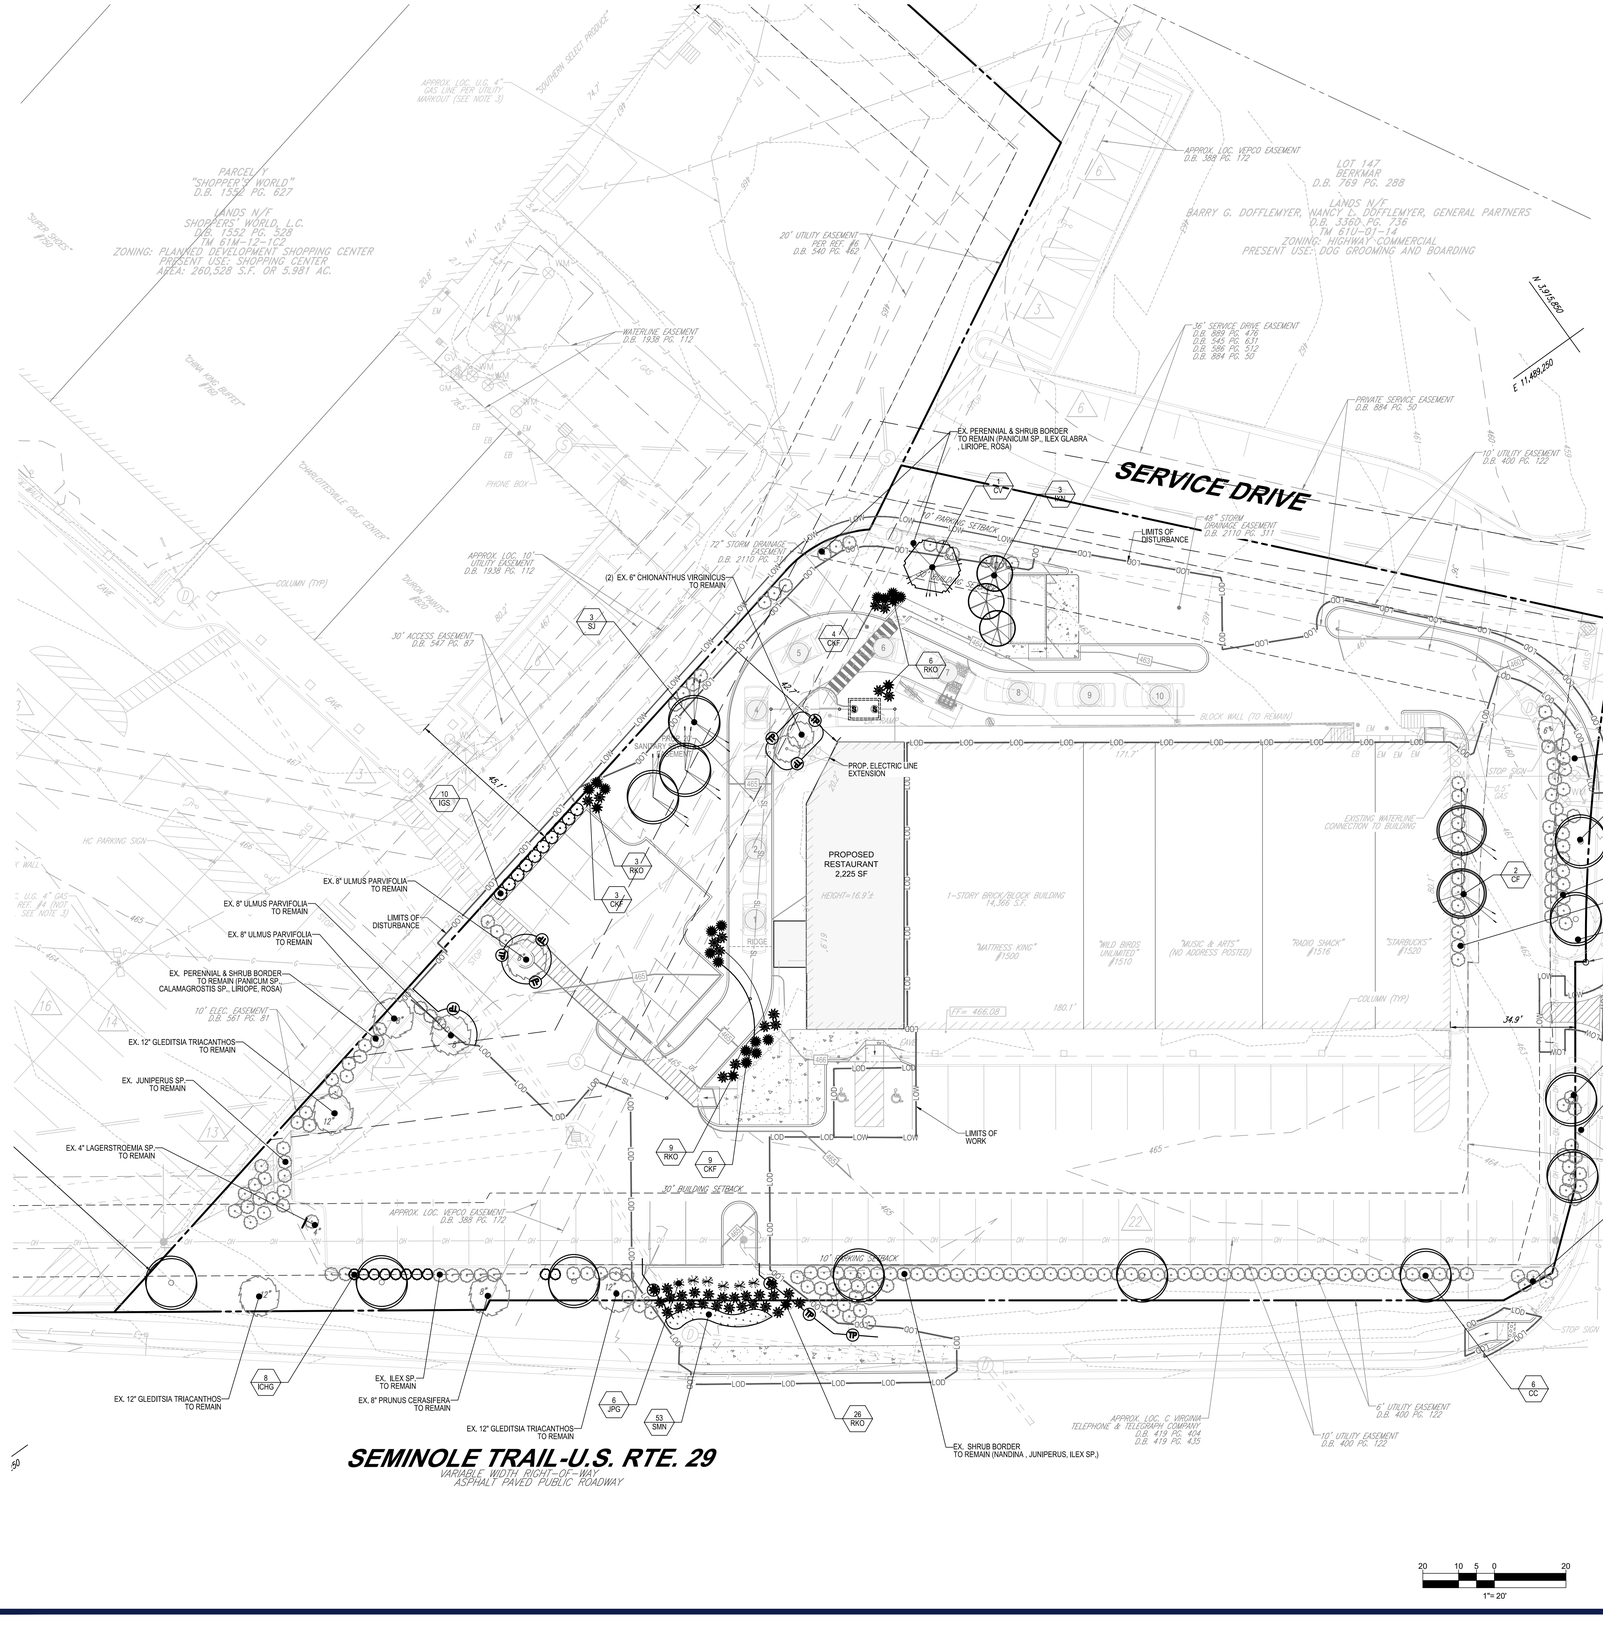

LANDSCAPE SCHEDULE

KEY	QTY.	BOTANICAL NAME	COMMON NAME	CAL. / HT.	CONT.
ORNAMENTAL TREES					
CC	10	CERCIS CANADENSIS 'FOREST PANSY'	FOREST PANSY REDBUD	1-1 1/2" CAL. / 8-10'	B+B
CF	2	CORNUS FLORIDA	WHITE FLOWERING DOGWOOD	1-1 1/2" CAL. / 8-10'	B+B
CV	1	CHIONANTHUS VIRGINICUS	WHITE FRINGETREE	6-8' HT.	B+B
SJ	4	STYRAX JAPONICA	JAPANESE SNOWBELL	1-1 1/2" CAL. / 8-10'	B+B
SUBTOTAL:	16				
EVERGREEN TREES					
IXN	3	ILEX X 'NELLIE R. STEVEN'	NELLIE R. STEVENS' HOLLY	6-8' HT.	B+B
SUBTOTAL:	3				
DECIDUOUS SHRUBS					
RK	44	ROSA 'KNOCKOUT'	KNOCKOUT ROSE	18-24" HT. & SPREAD	#3 CAN
SUBTOTAL:	44				
EVERGREEN SHRUBS					
ICHG	10	ILEX CRENATA 'HOOGENDORN'	HOOGENDORN JAPANESE HOLLY	15-18" HT. & SPREAD	#3 CAN
IGS	10	ILEX GLABRA 'SHAMROCK'	SHAMROCK INKBERRY HOLLY	24-30" HT. & SPREAD	#5 CAN
JPG	6	JUNIPERUS PFITZERIANA 'OLD GLOW'	OLD GLOW CHINESE JUNIPER	15-18" SPRD.	#3 CAN
SUBTOTAL:	26				
ORNAMENTAL GRASSES					
CKF	16	CALAMAGROSTIS ARUNDINACEA 'KARL FOERSTER'	FEATHER REED GRASS	2 GAL.	CONTAINER
SMN	53	SALVIA 'MAY NIGHT'	MAY NIGHT SALVIA		1 QT
SUBTOTAL:	69				

NOTE:

1. ALL SITE PLANTINGS OF TREES AND SHRUBS SHALL BE ALLOWED TO REACH, AND BE MAINTAINED AT, MATURE HEIGHT. THE TOPPING OF TREES IS PROHIBITED. SHRUBS AND TREES SHALL BE PRUNED MINIMALLY AND ONLY TO SUPPORT THE OVERALL HEALTH OF THE PLANT.

SEMINOLE TRAIL-U.S. RTE. 29
VARIABLE WIDTH RIGHT-OF-WAY
ASPHALT PAVED PUBLIC ROADWAY

BOHLER™
SITE CIVIL AND CONSULTING ENGINEERING
LAND SURVEYING
PROGRAM MANAGEMENT
LANDSCAPE ARCHITECTURE
SUSTAINABLE DESIGN
PERMITTING SERVICES
TRANSPORTATION SERVICES
THE INFORMATION, DESIGN AND CONCEPTS CONTAINED IN THIS PLAN ARE THE PROPERTY OF BOHLER AND ARE NOT TO BE USED FOR ANY PURPOSE OR PROJECT EXCEPT THE ONE SPECIFICALLY AUTHORIZED AND PROVIDED BY BOHLER IN WRITING. ANY UNAUTHORIZED USE, REPRODUCTION OR MODIFICATION OF THIS PLAN, IN WHOLE OR IN PART, IS STRICTLY PROHIBITED WITHOUT THE EXPRESS WRITTEN CONSENT OF BOHLER.

REVISIONS

REV	DATE	COMMENT	DRAWN BY / CHECKED BY

Know what's below. Call before you dig.
ALWAYS CALL 811
It's fast. It's free. It's the law.

NOT APPROVED FOR CONSTRUCTION
THIS DRAWING IS INTENDED FOR MUNICIPAL AND/OR AGENCY REVIEW AND APPROVAL. IT IS NOT INTENDED AS A CONSTRUCTION DOCUMENT UNLESS INDICATED OTHERWISE.

PROJECT No.:	V194600
DRAWN BY:	EEN
CHECKED BY:	RTY
DATE:	03/18/2020
CAD I.D.:	1

PROJECT:

MAJOR SITE PLAN AMENDMENT

FOR

29TH PLACE DRIVE THRU

LOCATION

1500 SEMINOLE TRAIL
CHARLOTTESVILLE, VA 22901
ALBEMARLE COUNTY

BOHLER
28 BLACKWELL PARK LANE, SUITE 201
WARRENTON, VIRGINIA 20186
Phone: (540) 349-4500
Fax: (540) 349-0321
VA@BohlerEng.com

COMMONWEALTH OF VIRGINIA
RYAN YAUGER
Lic. No. 0402056625
6/18/2020
PROFESSIONAL ENGINEER

SHEET TITLE:

LANDSCAPE PLAN

SHEET NUMBER:

C-601

REVISION 1 - 6/18/2020

U:\DATA\194600\ENGINEERING\MAJOR SITE PLAN\194600-LSP-0----LAYOUT1.C-601 - LANDSCAPE PLAN.DWG

LANDSCAPE SPECIFICATIONS

1. SCOPE OF WORK:
THE LANDSCAPE CONTRACTOR SHALL BE REQUIRED TO PERFORM ALL CLEARING, FINISHED GRADING, SOIL PREPARATION, PERMANENT SEEDING OR SODDING, PLANTING AND MULCHING INCLUDING ALL LABOR, MATERIALS, TOOLS AND EQUIPMENT NECESSARY FOR THE COMPLETION OF THIS PROJECT, UNLESS OTHERWISE CONTRACTED BY THE GENERAL CONTRACTOR.

2. MATERIALS

A. GENERAL - ALL HARDSCAPE MATERIALS SHALL MEET OR EXCEED SPECIFICATIONS AS OUTLINED IN THE STATE DEPARTMENT OF TRANSPORTATION'S SPECIFICATIONS.

B. TOPSOIL - NATURAL, FRIABLE, LOAMY SILT SOIL HAVING AN ORGANIC CONTENT NOT LESS THAN 5%, A PH RANGE BETWEEN 4.5-7.0. IT SHALL BE FREE OF DEBRIS, ROCKS LARGER THAN ONE INCH (1"), WOOD, ROOTS, VEGETABLE MATTER AND CLAY CLODS.

C. LAWN - ALL DISTURBED AREAS ARE TO BE TREATED WITH A MINIMUM SIX INCH (6") THICK LAYER OF TOPSOIL, OR AS DIRECTED BY THE LOCAL ORDINANCE OR CLIENT, AND SEEDED OR SODDED IN ACCORDANCE WITH THE PERMANENT STABILIZATION METHODS INDICATED WITHIN THE SOIL EROSION AND SEDIMENT CONTROL NOTES.
1.1. LAWN SEED MIXTURE SHALL BE FRESH, CLEAN NEW CROP SEED.
1.2. SOD SHALL BE STRONGLY ROOTED, WEED AND DISEASE/PEST FREE WITH A UNIFORM THICKNESS.
1.3. SOD INSTALLED ON SLOPES GREATER THAN 4:1 SHALL BE PEGGED TO HOLD SOD IN PLACE.

D. MULCH - THE MULCH AROUND THE PERIMETER OF THE BUILDING SHALL BE A 3" LAYER OF DOUBLE SHREDDED BLACK CEDAR MULCH ONLY. ALL OTHER AREAS SHALL BE MULCHED WITH A 3" LAYER OF DOUBLE SHREDDED DARK BROWN HARDWOOD BARK MULCH, UNLESS OTHERWISE STATED ON THE LANDSCAPE PLAN.

E. FERTILIZER
1.1. FERTILIZER SHALL BE DELIVERED TO THE SITE MIXED AS SPECIFIED IN THE ORIGINAL UNOPENED STANDARD BAGS SHOWING WEIGHT, ANALYSIS AND NAME OF MANUFACTURER. FERTILIZER SHALL BE STORED IN A WEATHERPROOF PLACE SO THAT IT CAN BE KEPT DRY PRIOR TO USE.
1.2. FOR THE PURPOSE OF BIDDING, ASSUME THAT FERTILIZER SHALL BE 10% NITROGEN, 6% PHOSPHORUS AND 4% POTASSIUM BY WEIGHT. A FERTILIZER SHOULD NOT BE SELECTED WITHOUT A SOIL TEST PERFORMED BY A CERTIFIED SOIL LABORATORY.

F. PLANT MATERIAL
1.1. ALL PLANTS SHALL IN ALL CASES CONFORM TO THE REQUIREMENTS OF THE "AMERICAN STANDARD FOR NURSERY STOCK" (ANSI Z60.1), LATEST EDITION, AS PUBLISHED BY THE AMERICAN NURSERY & LANDSCAPE ASSOCIATION.
1.2. IN ALL CASES, BOTANICAL NAMES SHALL TAKE PRECEDENCE OVER COMMON NAMES FOR ANY AND ALL PLANT MATERIAL.
1.3. PLANTS SHALL BE LEGIBLY TAGGED WITH THE PROPER NAME AND SIZE. TAGS ARE TO REMAIN ON AT LEAST ONE PLANT OF EACH SPECIES FOR VERIFICATION PURPOSES DURING THE FINAL INSPECTION.
1.4. TREES WITH ABRASION OF THE BARK, SUN SCALDS, DISFIGURATION OR FRESH CUTS OF LIMBS OVER 1¼", WHICH HAVE NOT BEEN COMPLETELY CALLUSED, SHALL BE REJECTED.PLANTS SHALL NOT BE BOUND WITH WIRE OR ROPE AT ANY TIME SO AS TO DAMAGE THE BARK OR BREAK BRANCHES.
1.5. ALL PLANTS SHALL BE TYPICAL OF THEIR SPECIES OR VARIETY AND SHALL HAVE A NORMAL HABIT OF GROWTH: WELL DEVELOPED BRANCHES, DENSELY FOLIATED, VIGOROUS ROOT SYSTEMS AND BE FREE OF DISEASE, INSECTS, PESTS, EGGS OR LARVAE.
1.6. CALIPER MEASUREMENTS OF NURSERY GROWN TREES SHALL BE TAKEN AT A POINT ON THE TRUNK SIX INCHES (6") ABOVE THE NATURAL GRADE FOR TREES UP TO AND INCLUDING A FOUR INCH (4") CALIPER SIZE. IF THE CALIPER AT SIX INCHES (6") ABOVE THE GROUND EXCEEDS FOUR INCHES (4") IN CALIPER, THE CALIPER SHOULD BE MEASURED AT A POINT 12" ABOVE THE NATURAL GRADE.
1.7. SHRUBS SHALL BE MEASURED TO THE AVERAGE HEIGHT OR SPREAD OF THE SHRUB, AND NOT TO THE LONGEST BRANCH.
1.8. TREES AND SHRUBS SHALL BE HANDLED WITH CARE BY THE ROOT BALL.

3. GENERAL WORK PROCEDURES

A. CONTRACTOR TO UTILIZE WORKMANLIKE INDUSTRY STANDARDS IN PERFORMING ALL LANDSCAPE CONSTRUCTION. THE SITE IS TO BE LEFT IN A CLEAN STATE AT THE END OF EACH WORKDAY. ALL DEBRIS, MATERIALS AND TOOLS SHALL BE PROPERLY STORED, STOCKPILED OR DISPOSED OF.

B. WASTE MATERIALS AND DEBRIS SHALL BE COMPLETELY DISPOSED OF AT THE CONTRACTOR'S EXPENSE. DEBRIS SHALL NOT BE BURIED, INCLUDING ORGANIC MATERIALS, BUT SHALL BE REMOVED COMPLETELY FROM THE SITE.

4. SITE PREPARATIONS

A. BEFORE AND DURING PRELIMINARY GRADING AND FINISHED GRADING, ALL WEEDS AND GRASSES SHALL BE DUG OUT BY THE ROOTS AND DISPOSED OF IN ACCORDANCE WITH GENERAL WORK PROCEDURES OUTLINED HEREIN.

B. ALL EXISTING TREES TO REMAIN SHALL BE PRUNED TO REMOVE ANY DAMAGED BRANCHES. THE ENTIRE LIMB OF ANY DAMAGED BRANCH SHALL BE CUT OFF AT THE TRUNK. CONTRACTOR SHALL ENSURE THAT CUTS ARE SMOOTH AND STRAIGHT. ANY EXPOSED ROOTS SHALL BE CUT BACK WITH CLEAN, SHARP TOOLS AND TOPSOIL SHALL BE PLACED AROUND THE REMAINDER OF THE ROOTS. EXISTING TREES SHALL BE MONITORED ON A REGULAR BASIS FOR ADDITIONAL ROOT OR BRANCH DAMAGE AS A RESULT OF CONSTRUCTION. ROOTS SHALL NOT BE LEFT EXPOSED FOR MORE THAN ONE (1) DAY. CONTRACTOR SHALL WATER EXISTING TREES AS NEEDED TO PREVENT SHOCK OR DECLINE.

C. CONTRACTOR SHALL ARRANGE TO HAVE A UTILITY STAKE-OUT TO LOCATE ALL UNDERGROUND UTILITIES PRIOR TO INSTALLATION OF ANY LANDSCAPE MATERIAL. UTILITY COMPANIES SHALL BE CONTACTED THREE (3) DAYS PRIOR TO THE BEGINNING OF WORK.

5. TREE PROTECTION

A. CONTRACTOR SHALL BE RESPONSIBLE FOR THE PROTECTION OF ALL EXISTING TREES TO REMAIN. A TREE PROTECTION ZONE SHALL BE ESTABLISHED AT THE DRIP LINE OR 15 FEET FROM THE TRUNK OR AT THE LIMIT OF CONSTRUCTION DISTURBANCE, WHICHEVER IS GREATER. LOCAL STANDARDS THAT MAY REQUIRE A MORE STRICT TREE PROTECTION ZONE SHALL BE HONORED.

B. A FORTY-EIGHT INCH (48") HIGH WOODEN SNOW FENCE OR ORANGE COLORED HIGH-DENSITY 'VISI-FENCE', OR APPROVED EQUAL, MOUNTED ON STEEL POSTS SHALL BE PLACED ALONG THE BOUNDARY OF THE TREE PROTECTION ZONE. POSTS SHALL BE LOCATED AT A MAXIMUM OF EIGHT FEET (8') ON CENTER OR AS INDICATED WITHIN THE TREE PROTECTION DETAIL.

C. WHEN THE TREE PROTECTION FENCING HAS BEEN INSTALLED, IT SHALL BE INSPECTED BY THE APPROVING AGENCY PRIOR TO DEMOLITION, GRADING, TREE CLEARING OR ANY OTHER CONSTRUCTION. THE FENCING ALONG THE TREE PROTECTION ZONE SHALL BE REGULARLY INSPECTED BY THE LANDSCAPE CONTRACTOR AND MAINTAINED UNTIL ALL CONSTRUCTION ACTIVITY HAS BEEN COMPLETED.

D. AT NO TIME SHALL MACHINERY, DEBRIS, FALLEN TREES OR OTHER MATERIALS BE PLACED, STOCKPILED OR LEFT STANDING IN THE TREE PROTECTION ZONE.

6. SOIL MODIFICATIONS

A. CONTRACTOR SHALL ATTAIN A SOIL TEST FOR ALL AREAS OF THE SITE PRIOR TO CONDUCTING ANY PLANTING. SOIL TESTS SHALL BE PERFORMED BY A CERTIFIED SOIL LABORATORY.

B. LANDSCAPE CONTRACTOR SHALL REPORT ANY SOIL OR DRAINAGE CONDITIONS CONSIDERED DETRIMENTAL TO THE GROWTH OF PLANT MATERIAL. SOIL MODIFICATIONS, AS SPECIFIED HEREIN, MAY NEED TO BE CONDUCTED BY THE LANDSCAPE CONTRACTOR DEPENDING ON SITE CONDITIONS.

C. THE FOLLOWING AMENDMENTS AND QUANTITIES ARE APPROXIMATE AND ARE FOR BIDDING PURPOSES ONLY. COMPOSITION OF AMENDMENTS SHOULD BE REVISED DEPENDING ON THE OUTCOME OF A TOPSOIL ANALYSIS PERFORMED BY A CERTIFIED SOIL LABORATORY.
1.1. TO INCREASE A SANDY SOIL'S ABILITY TO RETAIN WATER AND NUTRIENTS, THOROUGHLY TILL ORGANIC MATTER INTO THE TOP 6-12". USE COMPOSTED BARK, COMPOSTED LEAF MULCH OR PEAT MOSS. ALL PRODUCTS SHOULD BE COMPOSTED TO A DARK COLOR AND BE FREE OF PIECES WITH IDENTIFIABLE LEAF OR WOOD STRUCTURE. AVOID MATERIAL WITH A PH HIGHER THAN 7.5.
1.2. TO INCREASE DRAINAGE, MODIFY HEAVY CLAY OR SILT (MORE THAN 40% CLAY OR SILT) BY ADDING COMPOSTED PINE BARK (UP TO 30% BY VOLUME) AND/OR AGRICULTURAL GYPSUM. COARSE SAND MAY BE USED IF ENOUGH IS ADDED TO BRING THE SAND CONTENT TO MORE THAN 60% OF THE TOTAL MIX. SUBSURFACE DRAINAGE LINES MAY NEED TO BE ADDED TO INCREASE DRAINAGE.
1.3. MODIFY EXTREMELY SANDY SOILS (MORE THAN 85%) BY ADDING ORGANIC MATTER AND/OR DRY, SHREDDED CLAY LOAM UP TO 30% OF THE TOTAL MIX.

7. FINISHED GRADING

A. UNLESS OTHERWISE CONTRACTED, THE LANDSCAPE CONTRACTOR SHALL BE RESPONSIBLE FOR THE INSTALLATION OF TOPSOIL AND THE ESTABLISHMENT OF FINE-GRADING WITHIN THE DISTURBANCE AREA OF THE SITE.

B. LANDSCAPE CONTRACTOR SHALL VERIFY THAT SUBGRADE FOR INSTALLATION OF TOPSOIL HAS BEEN ESTABLISHED. THE SUBGRADE OF THE SITE MUST MEET THE FINISHED GRADE LESS THE REQUIRED TOPSOIL THICKNESS (1"±).

C. ALL LAWN AND PLANTING AREAS SHALL BE GRADED TO A SMOOTH, EVEN AND UNIFORM PLANE WITH NO ABRUPT CHANGE OF SURFACE AS DEPICTED WITHIN THIS SET OF CONSTRUCTION PLANS, UNLESS OTHERWISE DIRECTED BY THE PROJECT ENGINEER OR LANDSCAPE ARCHITECT.

D. ALL PLANTING AREAS SHALL BE GRADED AND MAINTAINED TO ALLOW FREE FLOW OF SURFACE WATER IN AND AROUND THE PLANTING BEDS. STANDING WATER SHALL NOT BE PERMITTED IN PLANTING BEDS.

8. TOPSOILING

A. CONTRACTOR SHALL PROVIDE A SIX INCH (6") THICK MINIMUM LAYER OF TOPSOIL, OR AS DIRECTED BY THE LOCAL ORDINANCE OR CLIENT, IN ALL PLANTING AREAS. TOPSOIL SHOULD BE SPREAD OVER A PREPARED SURFACE IN A UNIFORM LAYER TO ACHIEVE THE DESIRED COMPACTED THICKNESS.

B. ON-SITE TOPSOIL MAY BE USED TO SUPPLEMENT THE TOTAL AMOUNT REQUIRED. TOPSOIL FROM THE SITE MAY BE REJECTED IF IT HAS NOT BEEN PROPERLY REMOVED, STORED AND PROTECTED PRIOR TO CONSTRUCTION.

C. CONTRACTOR SHALL FURNISH TO THE APPROVING AGENCY AN ANALYSIS OF BOTH IMPORTED AND ON-SITE TOPSOIL TO BE UTILIZED IN ALL PLANTING AREAS. THE PH AND NUTRIENT LEVELS MAY NEED TO BE ADJUSTED THROUGH SOIL MODIFICATIONS AS NEEDED TO ACHIEVE THE REQUIRED LEVELS AS SPECIFIED IN THE MATERIALS SECTION ABOVE.

D. ALL PLANTING AND LAWN AREAS ARE TO BE CULTIVATED TO A DEPTH OF SIX INCHES (6"). ALL DEBRIS EXPOSED FROM EXCAVATION AND CULTIVATION SHALL BE DISPOSED OF IN ACCORDANCE WITH GENERAL WORK PROCEDURES SECTION ABOVE. THE FOLLOWING SHALL BE TILLED INTO THE TOP FOUR INCHES (4") IN TWO DIRECTIONS (QUANTITIES BASED ON A 1,000 SQUARE FOOT AREA):
1.1. 20 POUNDS 'GROW POWER' OR APPROVED EQUAL
1.2. 20 POUNDS NITRO-FORM (COURSE) 38-0-0 BLUE CHIP

E. THE SPREADING OF TOPSOIL SHALL NOT BE CONDUCTED UNDER MUDDY OR FROZEN CONDITIONS.

9. PLANTING

A. INSOFAR THAT IT IS FEASIBLE, PLANT MATERIAL SHALL BE PLANTED ON THE DAY OF DELIVERY. IN THE EVENT THAT THIS IS NOT POSSIBLE, LANDSCAPE CONTRACTOR SHALL PROTECT UNINSTALLED PLANT MATERIAL. PLANTS SHALL NOT REMAIN UNPLANTED FOR LONGER THAN A THREE DAY PERIOD AFTER DELIVERY. PLANTS THAT WILL NOT BE PLANTED FOR A PERIOD OF TIME GREATER THAN THREE DAYS SHALL BE HEALED IN WITH TOPSOIL OR MULCH TO HELP PRESERVE ROOT MOISTURE.

B. PLANTING OPERATIONS SHALL BE PERFORMED DURING PERIODS WITHIN THE PLANTING SEASON WHEN WEATHER AND SOIL CONDITIONS ARE SUITABLE AND IN ACCORDANCE WITH ACCEPTED LOCAL PRACTICE. PLANTS SHALL NOT BE INSTALLED IN TOPSOIL THAT IS IN A MUDDY OR FROZEN CONDITION.

C. ANY INJURED ROOTS OR BRANCHES SHALL BE PRUNED TO MAKE CLEAN-CUT ENDS PRIOR TO PLANTING UTILIZING CLEAN, SHARP TOOLS. ONLY INJURED OR DISEASED BRANCHING SHALL BE REMOVED.

D. ALL PLANTING CONTAINERS AND NON-BIODEGRADABLE MATERIALS SHALL BE REMOVED FROM ROOT BALLS DURING PLANTING. NATURAL FIBER BURLAP MUST BE CUT FROM AROUND THE TRUNK OF THE TREE AND FOLDED DOWN AGAINST THE ROOT BALL PRIOR TO BACKFILLING.

E. POSITION TREES AND SHRUBS AT THEIR INTENDED LOCATIONS AS PER THE PLANS AND SECURE THE APPROVAL OF THE LANDSCAPE ARCHITECT PRIOR TO EXCAVATING PITS, MAKING NECESSARY ADJUSTMENTS AS DIRECTED.

F. PRIOR TO THE ISSUANCE OF ANY CERTIFICATE OF OCCUPANCY, THE PROPOSED LANDSCAPE, AS SHOWN ON THE APPROVED LANDSCAPE PLAN, MUST BE INSTALLED, INSPECTED AND APPROVED BY THE APPROVING AGENCY. THE APPROVING AGENCY SHALL TAKE INTO ACCOUNT SEASONAL CONSIDERATIONS IN THIS REGARD AS FOLLOWS. THE PLANTING OF TREES, SHRUBS, VINES OR GROUND COVER SHALL OCCUR ONLY DURING THE FOLLOWING PLANTING SEASONS:
1.1. PLANTS: MARCH 15 TO DECEMBER 15
1.2. LAWN: MARCH 15 TO JUNE 15 OR SEPT. 1 TO DECEMBER 1

G. PLANTINGS REQUIRED FOR A CERTIFICATE OF OCCUPANCY SHALL BE PROVIDED DURING THE NEXT APPROPRIATE SEASON AT THE MUNICIPALITY'S DISCRETION. CONTRACTOR SHOULD CONTACT APPROVING AGENCY FOR POTENTIAL SUBSTITUTIONS.

H. FURTHERMORE, THE FOLLOWING TREE VARIETIES ARE UNUSUALLY SUSCEPTIBLE TO WINTER DAMAGE. WITH TRANSPLANT SHOCK AND THE SEASONAL LACK OF NITROGEN AVAILABILITY, THE RISK OF PLANT DEATH IS GREATLY INCREASED. IT IS NOT RECOMMENDED THAT THESE SPECIES BE PLANTED DURING THE FALL PLANTING SEASON:

ACER RUBRUM	PLATANUS X ACERIFOLIA
BETULA VARIETIES	POPULOUS VARIETIES
CARPINUS VARIETIES	PRUNUS VARIETIES
CRATAEGUS VARIETIES	PYRUS VARIETIES
KOELREUTERIA	QUERCUS VARIETIES
LIQUIDAMBER STYRACIFLUA	TILIA TOMENTOSA
LIRIODENDRON TULIPIFERA	ZELKOVA VARIETIES

I. PLANTING PITS SHALL BE DUG WITH LEVEL BOTTOMS, WITH THE WIDTH TWICE THE DIAMETER OF ROOT BALL. THE ROOT BALL SHALL REST ON UNDISTURBED GRADE. EACH PLANT PIT SHALL BE BACKFILLED IN LAYERS WITH THE FOLLOWING PREPARED SOIL MIXED THOROUGHLY:
- 1 PART PEAT MOSS
- 1 PART COMPOSTED COW MANURE BY VOLUME
- 3 PARTS TOPSOIL BY VOLUME
- 21 GRAMS 'AGRIFORM' PLANTING TABLETS (OR APPROVED EQUAL) AS FOLLOWS:
  - A) 2 TABLETS PER 1 GALLON PLANT
  - B) 3 TABLETS PER 5 GALLON PLANT
  - C) 4 TABLETS PER 15 GALLON PLANT
  - D) LARGER PLANTS: 2 TABLETS PER ½" CALIPER OF TRUNK

J. FILL PREPARED SOIL AROUND BALL OF PLANT HALF-WAY AND INSERT PLANT TABLETS. COMPLETE BACKFILL AND WATER THOROUGHLY.

K. ALL PLANTS SHALL BE PLANTED SO THAT THE TOP OF THE ROOT BALL, THE POINT AT WHICH THE ROOT FLARE BEGINS, IS SET AT GROUND LEVEL AND IN THE CENTER OF THE PIT. NO SOIL IS TO BE PLACED DIRECTLY ON TOP OF THE ROOT BALL.

L. ALL PROPOSED TREES DIRECTLY ADJACENT TO WALKWAYS OR DRIVEWAYS SHALL BE PRUNED AND MAINTAINED TO A MINIMUM BRANCHING HEIGHT OF 7' FROM GRADE.

M. GROUND COVER AREAS SHALL RECEIVE A ¼" LAYER OF HUMUS RAKED INTO THE TOP 1" OF PREPARED SOIL PRIOR TO PLANTING. ALL GROUND COVER AREAS SHALL BE WEEDED AND TREATED WITH A PRE-EMERGENT CHEMICAL AS PER MANUFACTURER'S RECOMMENDATION.

N. NO PLANT, EXCEPT GROUND COVERS, GRASSES OR VINES, SHALL BE PLANTED LESS THAN TWO FEET (2') FROM EXISTING STRUCTURES AND SIDEWALKS.

O. ALL PLANTING AREAS AND PLANTING PITS SHALL BE MULCHED AS SPECIFIED HEREIN TO FILL THE ENTIRE BED AREA OR SAUCER. NO MULCH IS TO TOUCH THE TRUNK OF THE TREE OR SHRUB.

P. ALL PLANTING AREAS SHALL BE WATERED IMMEDIATELY UPON INSTALLATION IN ACCORDANCE WITH THE WATERING SPECIFICATIONS AS LISTED HEREIN.

10. TRANSPLANTING (WHEN REQUIRED)

A. ALL TRANSPLANTS SHALL BE DUG WITH INTACT ROOT BALLS CAPABLE OF SUSTAINING THE PLANT.

B. IF PLANTS ARE TO BE STOCKPILED BEFORE REPLANTING, THEY SHALL BE HEALED IN WITH MULCH OR SOIL, ADEQUATELY WATERED AND PROTECTED FROM EXTREME HEAT, SUN AND WIND.

C. PLANTS SHALL NOT BE DUG FOR TRANSPLANTING BETWEEN APRIL 10 AND JUNE 30.

D. UPON REPLANTING, BACKFILL SOIL SHALL BE AMENDED WITH FERTILIZER AND ROOT GROWTH HORMONE.

E. TRANSPLANTS SHALL BE GUARANTEED FOR THE LENGTH OF THE GUARANTEE PERIOD SPECIFIED HEREIN.

F. IF TRANSPLANTS DIE, SHRUBS AND TREES LESS THAN SIX INCHES (6") DBH SHALL BE REPLACED IN KIND. TREES GREATER THAN SIX INCHES (6") DBH MAY BE REQUIRED TO BE REPLACED IN ACCORDANCE WITH THE MUNICIPALITY'S TREE REPLACEMENT GUIDELINES.

11. WATERING

A. NEW PLANTINGS OR LAWN AREAS SHALL BE ADEQUATELY IRRIGATED BEGINNING IMMEDIATELY AFTER PLANTING. WATER SHALL BE APPLIED TO EACH TREE AND SHRUB IN SUCH MANNER AS NOT TO DISTURB BACKFILL AND TO THE EXTENT THAT ALL MATERIALS IN THE PLANTING HOLE ARE THOROUGHLY SATURATED. WATERING SHALL CONTINUE AT LEAST UNTIL PLANTS ARE ESTABLISHED.

B. SITE OWNER SHALL PROVIDE WATER IF AVAILABLE ON SITE AT TIME OF PLANTING. IF WATER IS NOT AVAILABLE ON SITE, CONTRACTOR SHALL SUPPLY ALL NECESSARY WATER. THE USE OF WATERING BAGS IS RECOMMENDED FOR ALL NEWLY PLANTED TREES.

C. IF AN IRRIGATION SYSTEM HAS BEEN INSTALLED ON THE SITE, IT SHALL BE USED TO WATER PROPOSED PLANT MATERIAL, BUT ANY FAILURE OF THE SYSTEM DOES NOT ELIMINATE THE CONTRACTOR'S RESPONSIBILITY OF MAINTAINING THE DESIRED MOISTURE LEVEL FOR VIGOROUS, HEALTHY GROWTH.

12. GUARANTEE

A. THE LANDSCAPE CONTRACTOR SHALL GUARANTEE ALL PLANTS FOR A PERIOD OF ONE (1) YEAR FROM APPROVAL OF LANDSCAPE INSTALLATION BY THE APPROVING AGENCY. CONTRACTOR SHALL SUPPLY THE OWNER WITH A MAINTENANCE BOND FOR TEN PERCENT (10%) OF THE VALUE OF THE LANDSCAPE INSTALLATION WHICH WILL BE RELEASED AT THE CONCLUSION OF THE GUARANTEE PERIOD AND WHEN A FINAL INSPECTION HAS BEEN COMPLETED AND APPROVED BY THE OWNER OR AUTHORIZED REPRESENTATIVE.

B. ANY DEAD OR DYING PLANT MATERIAL SHALL BE REPLACED FOR THE LENGTH OF THE GUARANTEE PERIOD. REPLACEMENT OF PLANT MATERIAL SHALL BE CONDUCTED AT THE FIRST SUCCEEDING PLANTING SEASON. ANY DEBRIS SHALL BE DISPOSED OF OFF-SITE, WITHOUT EXCEPTION.

C. TREES AND SHRUBS SHALL BE MAINTAINED BY THE CONTRACTOR DURING CONSTRUCTION AND THROUGHOUT THE 90 DAY MAINTENANCE PERIOD AS SPECIFIED HEREIN. CULTIVATION, WEEDING, WATERING AND THE PREVENTATIVE TREATMENTS SHALL BE PERFORMED AS NECESSARY TO KEEP PLANT MATERIAL IN GOOD CONDITION AND FREE OF INSECTS AND DISEASE.

D. LAWNS SHALL BE MAINTAINED THROUGH WATERING, FERTILIZING, WEEDING, MOWING, TRIMMING AND OTHER OPERATIONS SUCH AS ROLLING, REGARDING AND REPLANTING AS REQUIRED TO ESTABLISH A SMOOTH, ACCEPTABLE LAWN, FREE OF ERODED OR BARE AREAS.

13. CLEANUP

A. UPON THE COMPLETION OF ALL LANDSCAPE INSTALLATION AND BEFORE THE FINAL ACCEPTANCE, THE CONTRACTOR SHALL REMOVE ALL UNUSED MATERIALS, EQUIPMENT AND DEBRIS FROM THE SITE. ALL PAVED AREAS ARE TO BE CLEANED.

B. THE SITE SHALL BE CLEANED AND LEFT IN A NEAT AND ACCEPTABLE CONDITION AS APPROVED BY THE OWNER OR AUTHORIZED REPRESENTATIVE.

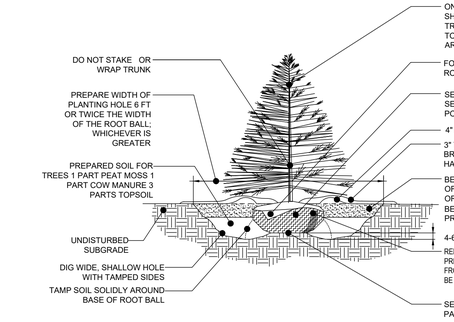

REFERENCE: ARCHITECTURAL GRAPHIC STANDARDS 1998 CUMULATIVE SUPPLEMENT.

EVERGREEN TREE PLANTING DETAIL

NOT TO SCALE

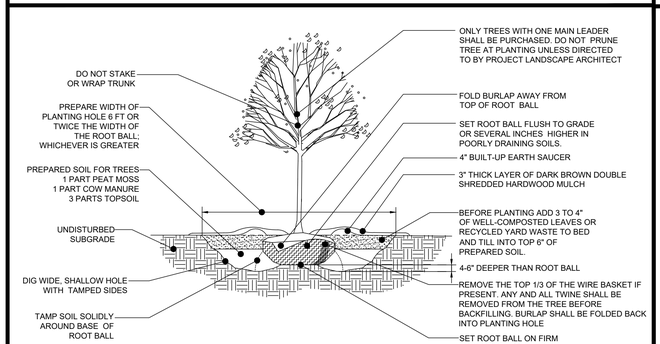

REFERENCE: ARCHITECTURAL GRAPHIC STANDARDS 1998 CUMULATIVE SUPPLEMENT.

DECIDUOUS TREE PLANTING DETAIL

NOT TO SCALE

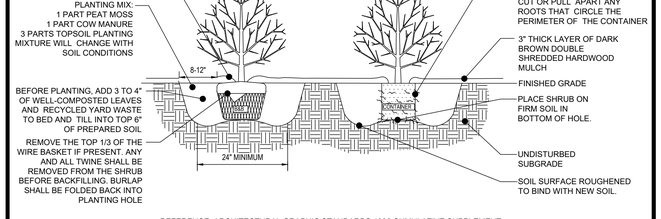

REFERENCE: ARCHITECTURAL GRAPHIC STANDARDS 1998 CUMULATIVE SUPPLEMENT

DECIDUOUS AND EVERGREEN SHRUB PLANTING DETAIL

NOT TO SCALE

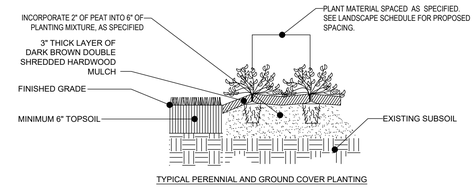

TYPICAL PERENNIAL AND GROUND COVER PLANTING

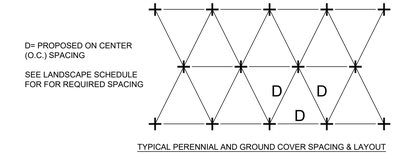

TYPICAL PERENNIAL AND GROUND COVER SPACING & LAYOUT

PERENNIAL/GROUND COVER PLANTING DETAIL

NOT TO SCALE

NOTE: TREE STAKING TO BE REMOVED AFTER 2 GROWING SEASONS

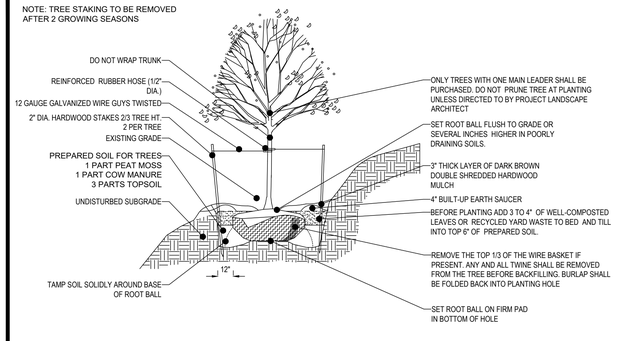

TREE PLANTING ON SLOPE DETAIL

NOT TO SCALE

SEEDING SPECIFICATIONS

1. MATERIAL:

1.1. SEED MIXTURE MUST BE COMPRISED OF THE FOLLOWING VARIETIES AND AT THE SPECIFIED COMPOSITION:
1.1.1. 80% - TURF TYPE TALL FESCUE SEED
1.1.2. 10% - KENTUCKY BLUEGRASS SEED
1.1.3. 10% - ANNUAL RYE GRASS SEED
1.2. INSTALLATION RATES:
1.2.1. SEED: LAWN SEED SHOULD BE APPLIED AT A RATE OF 7 LBS/1,000 SF
1.2.2. LIME: AGRICULTURAL OR PELLETIZED LIME SHOULD BE APPLIED AT SPECIFIED RATE ACCORDING TO SOIL ANALYSIS OR 2,000 LBS PER ACRE (46 LBS/1,000 SF) IF NO SOIL ANALYSIS IS PERFORMED.
1.2.3. FERTILIZER: COMMERCIAL GRADE 12-20-12 SHOULD BE APPLIED AT A RATE OF 250 LBS PER PER ACRE (5.8 LBS/ 1,000 SF)
1.2.4. LIQUID OR DRY LIME: LIQUID LIME SHOULD BE APPLIED AT A RATE OF 2.5 GALLONS PER ACRE OR NEUTRA LIME DRY APPLIED AT A RATE OF 80LBS PER ACRE IN AREAS OF ACIDIC SOILS TO ASSURE GERMINATION AND INITIAL ESTABLISHMENT.
1.2.5. MULCH: WHEAT, OAT, OR BARLEY STRAW MULCH SH

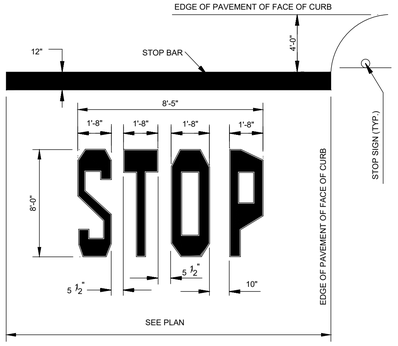

NOTE:
1. WORDS AND ARROWS FOR DRIVEWAYS SHALL BE APPLIED ACCORDING TO REQUIREMENTS AS OUTLINED IN SECTION 3B OF THE MANUAL ON UNIFORM TRAFFIC CONTROL DEVICES FOR STREETS AND HIGHWAYS
2. THESE WORDS AND BAR ARE TO BE PAINTED REFLECTIVE WHITE.

STOP BAR
N.T.S.

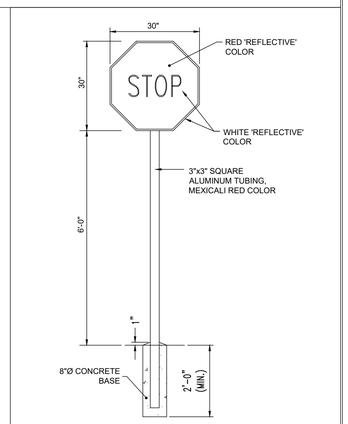

STOP SIGN & STANDARD MOUNTING POST
N.T.S.

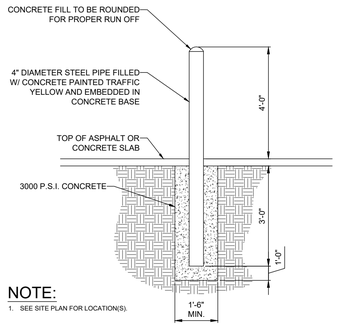

NOTE:
1. SEE SITE PLAN FOR LOCATION(S).

BOLLARD DETAIL
NOT TO SCALE

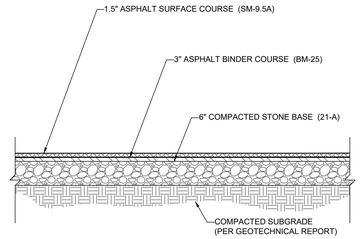

NOTE:
1. SECTION SHOWN IS BASED ON THE EXISTING PAVEMENT SECTION FOR THE SHOPPING CENTER. CONTRACTOR SHALL CONFIRM IN THE FIELD AND NOTIFY ENGINEER OF ANY DISCREPANCIES BETWEEN THE EXISTING SECTION AND THE SECTION SHOWN ABOVE.

STANDARD DUTY ASPHALT PAVEMENT SECTION
NOT TO SCALE

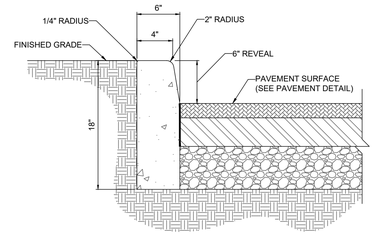

NOTES:
1. EXPANSION JOINTS TO BE INSTALLED AT 20' INTERVALS.
2. THIS ITEM MAY BE PRECAST OR CAST IN PLACE.
3. CONCRETE TO BE CLASS A3 IF CAST IN PLACE OR 4000 P.S.I. IF PRECAST.

HEADER CURB DETAIL
NOT TO SCALE

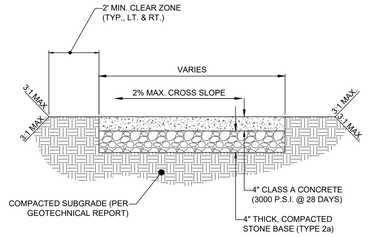

NOTE:
1. EXPANSION JOINTS 1/2" WIDE PREMOLDED BIT. MATERIAL SHALL BE INSTALLED AT 30' INTERVALS, CRACK CONTROL JOINTS TO BE SPACED AT INTERVALS EQUAL TO SIDEWALK WIDTH.

CONCRETE SIDEWALK DETAIL
NOT TO SCALE

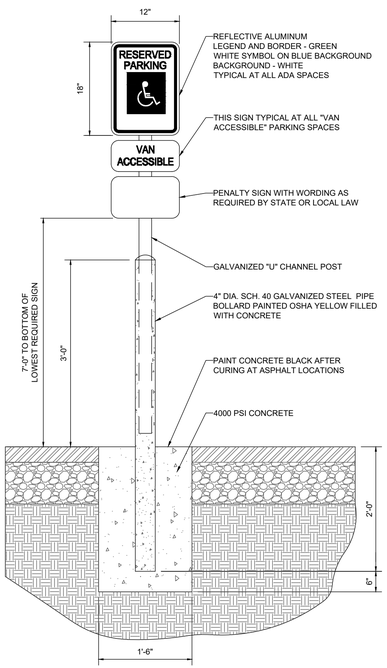

NOTE:
ONE AT EACH ADA SPACE. WHERE ADA SPACES FACE EACH OTHER WITHOUT WALKWAY, THERE SHALL BE ONE POST WITH SIGNS MOUNTED BOTH SIDES

BOLLARD MOUNTED ADA PARKING SIGN DETAIL
NOT TO SCALE

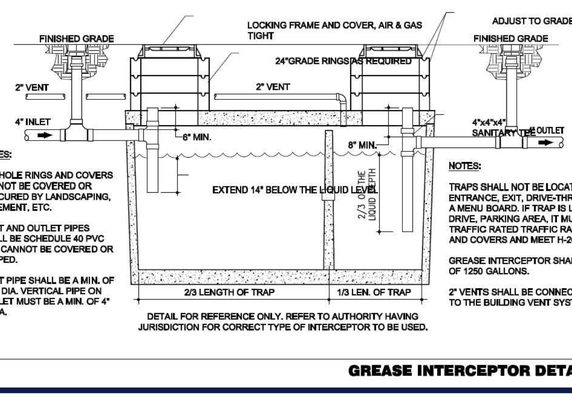

NOTES:

MANHOLE RINGS AND COVERS CANNOT BE COVERED OR OBSCURED BY LANDSCAPING, PAVEMENT, ETC.

INLET AND OUTLET PIPES SHALL BE SCHEDULE 40 PVC AND CANNOT BE COVERED OR CAPPED.

INLET PIPE SHALL BE A MIN. OF 4" IN DIA. VERTICAL PIPE ON OUTLET MUST BE A MIN. OF 4" IN DIA.

NOTES:

TRAPS SHALL NOT BE LOCATED IN AN ENTRANCE, EXIT, DRIVE-THRU OR UNDER A MENU BOARD. IF TRAP IS LOCATED IN A DRIVE, PARKING AREA, IT MUST CONTAIN TRAFFIC RATED TRAFFIC RATED RINGS AND COVERS AND MEET H-20 LOADING.

GREASE INTERCEPTOR SHALL BE A MIN. OF 1250 GALLONS.

2" VENTS SHALL BE CONNECTED TO THE BUILDING VENT SYSTEM.

DETAIL FOR REFERENCE ONLY. REFER TO AUTHORITY HAVING JURISDICTION FOR CORRECT TYPE OF INTERCEPTOR TO BE USED.

GREASE INTERCEPTOR DETAIL N.T.S. | D

CG-12

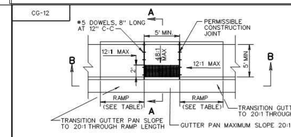

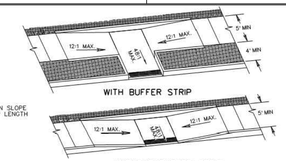

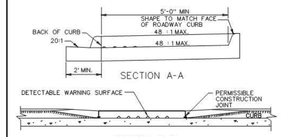

NOTES:
1. FOR GENERAL NOTES ON THE DETECTABLE WARNING SURFACE, SEE SHEET 1 OF 5.
2. THE REQUIRED LENGTH OF A PARALLEL RAMP IS LIMITED TO 15 FEET, REGARDLESS OF THE SLOPE.
3. GUTTER PAN SHALL BE A MAXIMUM SLOPE OF 20:1 AT THE RAMP OPENING.
4. DIAGONAL PLACEMENT IS NOT PERMITTED.

TYPE B PARALLEL APPLICATION

ROADWAY GRADE IN PERCENT	MINIMUM RAMP LENGTH IN FEET	
	4" CURB	6" CURB
0	4	6
1	5	7
2	5	8
3	6	9
4	8	12
5	10	15
6	14	15

EXAMPLE INSTALLATION METHODS - SEE PLANS FOR LAYOUT

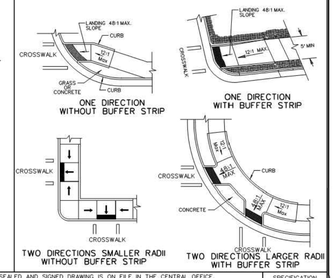

VDOT ROAD AND BRIDGE STANDARDS | SHEET 3 OF 5 | 204.03 | REVISION DATE 04/19

A COPY OF THE ORIGINAL SEALED AND SIGNED DRAWING IS ON FILE IN THE CENTRAL OFFICE.

CG-12 DETECTABLE WARNING SURFACE
TYPE B (PARALLEL) APPLICATION
VIRGINIA DEPARTMENT OF TRANSPORTATION

SPECIFICATION REFERENCE: 105, 502, 504 | CG-12

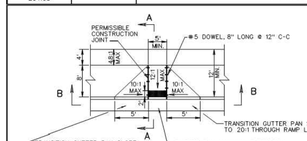

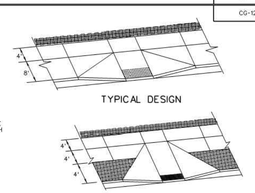

NOTES:
1. FOR GENERAL NOTES ON THE DETECTABLE WARNING SURFACE, SEE SHEET 1 OF 5.
2. THIS DESIGN TO BE USED FOR CONSTRUCTION THAT INCORPORATES WIDER SIDEWALK, LANDING (4' WIDE) REQUIRED AT TOP OF CURB RAMP. MINIMUM CURB RAMP LENGTH 8 FEET FOR NEW CONSTRUCTION.
3. GUTTER PAN SHALL BE A MAXIMUM SLOPE OF 20:1 AT THE RAMP OPENING.
4. DIAGONAL PLACEMENT IS NOT PERMITTED.

EXAMPLE INSTALLATION METHODS - SEE PLANS FOR LAYOUT

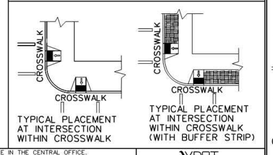

SPECIFICATION REFERENCE: 105, 502, 504

A COPY OF THE ORIGINAL SEALED AND SIGNED DRAWING IS ON FILE IN THE CENTRAL OFFICE.

CG-12 DETECTABLE WARNING SURFACE
TYPE A (PERPENDICULAR) APPLICATION
VIRGINIA DEPARTMENT OF TRANSPORTATION

VDOT ROAD AND BRIDGE STANDARDS | REVISION DATE 04/19 | SHEET 2 OF 5 | 204.02

WP-2

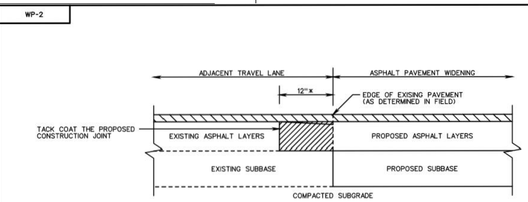

CONSTRUCTION JOINT DETAIL

REMOVE EXISTING ASPHALT LAYERS TO EXISTING SUBBASE AND REPLACE WITH PROPOSED ASPHALT WIDENING LAYERS
PROPOSED MINIMUM 1½ INCH THICK ASPHALT SURFACE COURSE (SEE NOTE 5)
× MINIMUM 12 INCHES, OR GREATER AS NECESSARY TO ABUT THE FULL THICKNESS OF EXISTING ASPHALT LAYERS AS DETERMINED BY CORES (SEE NOTE 3)

NOTES:
1. ASPHALT PAVEMENT WIDENING SHALL HAVE A PAVEMENT DESIGN IN ACCORDANCE WITH CURRENT VDOT PROCEDURES AND BE APPROVED BY THE ENGINEER.
2. THE PAVEMENT DESIGN FOR ASPHALT PAVEMENT WIDENING SHALL MEET OR EXCEED THE DEPTHS AND TYPES OF THE LAYERS OF EXISTING PAVEMENT. SUBSURFACE DRAINAGE OF THE EXISTING AND PROPOSED PAVEMENT SHALL BE ADDRESSED IN THE PAVEMENT DESIGN.
3. A MINIMUM OF THREE CORES SHALL BE TAKEN ALONG THE CENTER OF THE ADJACENT TRAVEL LANE TO DETERMINE THE TYPE AND THICKNESS OF EXISTING PAVEMENT LAYERS. THESE CORES SHALL BE SPACED NO MORE THAN 500 FEET APART.
4. THE ADJACENT TRAVEL LANE SHALL BE MILLED A MINIMUM DEPTH OF 1½ INCHES AND REPLACED WITH AN ASPHALT SURFACE COURSE TO MATCH THE PROPOSED PAVEMENT WIDENING SURFACE COURSE, UNLESS WAIVED BY THE ENGINEER.
5. THE ENGINEER MAY REQUIRE THE MILLING DEPTH OF THE EXISTING PAVEMENT TO BE ADJUSTED TO ACHIEVE AN ACCEPTABLE PAVEMENT CROSS-SLOPE AND EFFECTIVE SURFACE DRAINAGE.
6. EXISTING PAVEMENT MARKINGS AND MARKERS WITHIN THE PROJECT LIMITS SHALL BE RESTORED SUBJECT TO THE APPROVAL OF THE ENGINEER.
7. FINAL TRANSVERSE PAVEMENT TIE-IN SHALL CONFORM TO THE REQUIREMENTS OF SECTION 315.05(c) OF THE SPECIFICATIONS EXCEPT THAT ALL JOINTS AT TIE-IN LOCATIONS SHALL BE TESTED USING A 10 FOOT STRAIGHTEDGE IN ACCORDANCE WITH THE REQUIREMENTS OF SECTION 315.07(a) OF THE SPECIFICATIONS.

VDOT ROAD AND BRIDGE STANDARDS | SHEET 1 OF 1 | 303.02 | REVISION DATE

PAVEMENT WIDENING
VIRGINIA DEPARTMENT OF TRANSPORTATION

SPECIFICATION REFERENCE: 315

DI-1

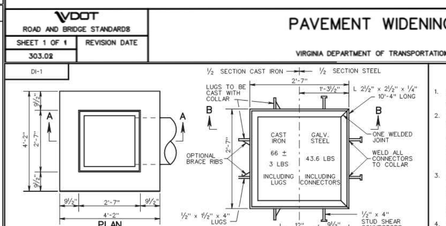

CONCRETE QUANTITIES FOR MIN. DEPTH
12" CONCRETE PIPE - 1.440 CU. YD. CONCRETE
15" CONCRETE PIPE - 1.528 CU. YD. CONCRETE
18" CONCRETE PIPE - 1.620 CU. YD. CONCRETE
24" CONCRETE PIPE - 1.817 CU. YD. CONCRETE
ADD 0.469 CU. YD. PER ADDITIONAL FOOT OF DEPTH.

NOTES
1. DEPTH OF INLET (H) TO BE SHOWN ON PLANS. FOR DEPTH GREATER THAN 10' USE STANDARD DI-1A
2. THE "H" DIMENSION SHOWN ON THE STANDARDS AND SPECIFIED ON THE PLANS WILL BE MEASURED FROM THE INVERT OF THE STRUCTURE TO THE TOP OF THE STRUCTURE. PLAN "H" DIMENSIONS ARE APPROXIMATE ONLY FOR ESTIMATING PURPOSES AND THE ACTUAL DIMENSIONS SHALL BE DETERMINED BY THE CONTRACTOR FROM FIELD CONDITIONS.
3. WHEN SPECIFIED ON THE PLANS THE INVERT (T) TO BE SHAPED IN ACCORDANCE WITH STANDARD IS-1. THE COST OF FURNISHING AND PLACING ALL MATERIALS INCIDENTAL TO THE SHAPING IS TO BE INCLUDED IN THE BID PRICE FOR THE STRUCTURE.
4. IN THE EVENT THE INVERT OF THE OUTFALL PIPE IS HIGHER THAN THE BOTTOM OF THE STRUCTURE, THE INVERT OF THE STRUCTURE SHALL BE SHAPED WITH CEMENT MORTAR TO PREVENT STANDING OR PONDING OF WATER IN THE STRUCTURE. THE COST OF FURNISHING AND PLACING ALL MATERIALS INCIDENTAL TO INLET SHAPING IS TO BE INCLUDED IN THE BID PRICE FOR THE STRUCTURE.
5. STEPS ARE TO BE PROVIDED WHEN H IS 4'-0" OR GREATER. FOR DETAILS SEE STANDARD ST-1.
6. THIS ITEM MAY BE PRECAST OR CAST-IN-PLACE.
7. #4 X 8" SMOOTH DOWELS AT APPROXIMATELY 12" C-C TO BE PLACED IN ALL AREAS ADJACENT TO CAST-IN-PLACE CONCRETE TO PREVENT SETTLEMENT. IN LIEU OF DOWELS A 2"X4" NOTCH MAY BE PROVIDED. SEE STANDARD 7-SD-3.4 FOR ALTERNATE DESIGN.
8. 3" DIAMETER WEEP HOLE WITH 12"X12" PLASTIC OR GALVANIZE CLOTH ¼" MESH OR GALVANIZED STEEL WIRE MINIMUM WIRE DIAMETER 0.037", NUMBER 4 MESH HARDWARE CLOTH ANCHORED FIRMLY TO THE OUTSIDE OF THE STRUCTURE.
9. CAST IN PLACE CONCRETE IS TO BE CLASS A3 CONCRETE. PRECAST CONCRETE IS TO BE 4000 PSI.
10. ANY ALTERNATE METHODS OF ANCHORAGE MEETING THE APPROVAL OF THE ENGINEER, MAY BE SUBSTITUTED FOR THE CAST IRON LUGS AS SHOWN HEREON.
11. DUMP NO WASTE DRAINS TO WATERWAY LETTERING IS REQUIRED ON ALL DI-1 GRATES. LOCATION OF LETTERING MAY VARY BY MANUFACTURER.

VDOT ROAD AND BRIDGE STANDARDS | SHEET 1 OF 1 | 104.01 | REVISION DATE

STANDARD DROP INLET
12" - 24" PIPE: MAXIMUM DEPTH (H) = 10'
VIRGINIA DEPARTMENT OF TRANSPORTATION

SPECIFICATION REFERENCE: 233, 302

BOHLER
SITE CIVIL AND CONSULTING ENGINEERING
LAND SURVEYING
PROGRAM MANAGEMENT
LANDSCAPE ARCHITECTURE
SUSTAINABLE DESIGN
PERMITTING SERVICES
TRANSPORTATION SERVICES
THE INFORMATION, DESIGN AND CONCEPTS OF THIS PLAN ARE PROPRIETARY AND SHALL NOT BE COPIED OR USED, IN WHOLE OR IN PART, FOR ANY PURPOSE WITHOUT PRIOR WRITTEN AUTHORIZATION FROM BOHLER. ONLY APPROVED AND SIGNED PLANS SHALL BE UTILIZED FOR CONSTRUCTION PURPOSES.
© 2020 BOHLER

REVISIONS

REV	DATE	COMMENT	DRAWN BY / CHECKED BY

811 Know what's below. Call before you dig.
ALWAYS CALL 811
It's fast. It's free. It's the law.

NOT APPROVED FOR CONSTRUCTION

THIS DRAWING IS INTENDED FOR MUNICIPAL AND/OR AGENCY REVIEW AND APPROVAL. IT IS NOT INTENDED AS A CONSTRUCTION DOCUMENT UNLESS INDICATED OTHERWISE.

PROJECT No.:	V194600
DRAWN BY:	EEN
CHECKED BY:	RTY
DATE:	03/18/2020
CAD I.D.:	1

PROJECT:

MAJOR SITE PLAN AMENDMENT

FOR

29TH PLACE DRIVE THRU

LOCATION

1500 SEMINOLE TRAIL
CHARLOTTESVILLE, VA 22901
ALBEMARLE COUNTY

BOHLER
28 BLACKWELL PARK LANE, SUITE 201
WARRENTON, VIRGINIA 20186
Phone: (540) 349-4500
Fax: (540) 349-0321
VA@BohlerEng.com

COMMONWEALTH OF VIRGINIA
RYAN YAUGER
Lic. No. 0402056625
6/18/2020
PROFESSIONAL ENGINEER

SHEET TITLE:

CONSTRUCTION DETAILS

SHEET NUMBER:

C-801

REVISION 1 - 6/18/2020

J:\BOHLER\projects\V194600\PLAN SETS\MAJOR SITE\V194600-SITE-1-LAYOUT (C-801) - CONST. DETAILS.dwg

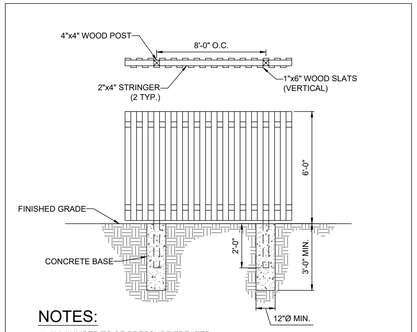

NOTES:

1. ALL LUMBER TO BE PRESSURE TREATED.
2. USE 6"x6" POSTS AT ALL CORNERS (ANGLE POINTS).

BOARD ON BOARD FENCE DETAIL

NOT TO SCALE

DUMPSTER ENCLOSURE EXHIBIT

NOT TO SCALE

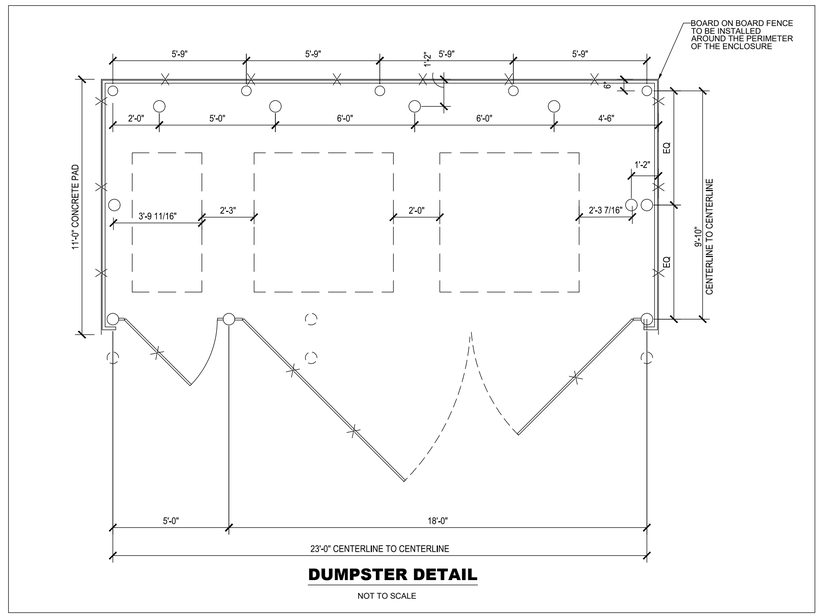

DUMPSTER DETAIL

NOT TO SCALE

BOHLER

SITE CIVIL AND CONSULTING ENGINEERING
LAND SURVEYING
PROGRAM MANAGEMENT
LANDSCAPE ARCHITECTURE
STRUCTURAL DESIGN
PERMITTING SERVICES
TRANSPORTATION SERVICES

THE INFORMATION, DESIGN AND CONCEPTS OF THIS PLAN ARE PROPRIETARY AND SHALL NOT BE COPIED OR USED, OR ANY PORTION ASSIGNED, TRANSFERRED OR DISCLOSED TO ANY UNAUTHORIZED PERSON WITHOUT THE WRITTEN AUTHORIZATION FROM BOHLER. ONLY APPROVED AND SEALED PLANS SHALL BE UTILIZED FOR CONSTRUCTION PURPOSES BY BOHLER.

REVISIONS

REV	DATE	COMMENT	DRAWN BY / CHECKED BY

Know what's below. Call before you dig.

ALWAYS CALL 811

It's fast. It's free. It's the law.

NOT APPROVED FOR CONSTRUCTION

THIS DRAWING IS INTENDED FOR MUNICIPAL AND/OR AGENCY REVIEW AND APPROVAL. IT IS NOT INTENDED AS A CONSTRUCTION DOCUMENT UNLESS INDICATED OTHERWISE.

PROJECT No.:	V194600
DRAWN BY:	EEN
CHECKED BY:	RTY
DATE:	03/18/2020
CAD I.D.:	1

PROJECT:

MAJOR SITE PLAN AMENDMENT

FOR

29TH PLACE DRIVE THRU

LOCATION

1500 SEMINOLE TRAIL
CHARLOTTESVILLE, VA 22901
ALBEMARLE COUNTY

BOHLER

28 BLACKWELL PARK LANE, SUITE 201
WARRENTON, VIRGINIA 20186
Phone: (540) 349-4500
Fax: (540) 349-0321
VA@BohlerEng.com

COMMONWEALTH OF VIRGINIA
RYAN YAUGER
Lic. No. 0402056625
6/18/2020
PROFESSIONAL ENGINEER

SHEET TITLE:

CONSTRUCTION DETAILS

SHEET NUMBER:

C-802

REVISION 1 - 6/18/2020

H:\V194600\CAD\LAYOUTS\PLAN SET\MAJOR SP\V194600-SP(V1)-C-802- CONST. DETAILS

Typical Traffic Control
Shoulder Operation with Minor Encroachment
(Figure TTC-5.2)

NOTES

Standard

1. **For required sign assemblies for multi-lane roadways see Note 1, TTC-4.**[1]

Guidance

2. *Sign spacing should be 1300'-1500' for Limited Access highways. For all other roadways, the sign spacing should be 500'-800' where the posted speed limit is greater than 45 mph, and 350'-500' where the posted speed limit is 45 mph or less.*
3. *When work takes up part of a lane on a high volume roadway; vehicular traffic volumes, vehicle mix, speed and capacity should be analyzed to determine whether the affected lane should be closed. Unless the lane encroachment analysis permits a remaining lane width of 10 feet, the lane should be closed. If the closure operation is on a Limited Access highway, the minimum lane width is 11 feet.*

Option:

4. The ROAD WORK AHEAD (W20-1) sign on an intersecting roadway may be omitted where drivers emerging from that roadway will encounter another advance warning sign prior to this activity area.

Standard:

5. **A shadow vehicle with either an arrow board operating in the caution mode, or at least one high-intensity amber rotating, flashing, or[1] oscillating light shall be parked 80' - 120' in advance of the first work crew.**
6. **Vehicle hazard warning signals shall not be used instead of the vehicle's high-intensity amber rotating, flashing, or[1] oscillating lights. Vehicle hazard warning signals can be used to supplement high-intensity amber rotating, flashing, or[1] oscillating lights.**
7. **Taper length (L) and channelizing device spacing shall be at the following:**

Taper Length L

Speed Limit (mph)	Lane Width (Feet) 9	10	11	12	Remarks	Speed Limit (mph)	Lane Width (Feet) 9	10	11	12	Remarks
25	95	105	115	125	L=S²W/60	50	450	500	550	600	L=SW
30	135	150	165	180	L=S²W/60	55	495	550	605	660	L= SW
35	185	205	225	245	L=S²W/60	60	540	600	660	720	L=SW
40	240	270	295	320	L=S²W/60	65	585	650	715	780	L=SW
45	405	450	495	540	L=SW	70	630	700	770	840	L=SW

Limited Access highways shall use a 1000' merging taper regardless of the posted speed, a 750' shifting taper for posted speeds < 65 mph and a 1000' shifting taper for posted speeds ≥ 65 mph.[2]

Shoulder Taper = ½ L Minimum

8. **Channelizing device spacing shall be at the following:**

Channelizing Device Spacing						
Location Spacing	Speed Limit (mph) 0 -35	36 +	Location Spacing	Speed Limit (mph) 0 -35	36 +	Location Spacing	Speed Limit (mph) 0 -35	36 +
Transition	20'	40'	Taper/way	40'	80'	*Construction Access	80'	120'

*Construction access spacing may be increased to this distance, but shall not exceed one access per ¼ mile.

9. **On roadways with paved shoulders having a width of 8 feet or more, channelizing devices shall be used to close the shoulder in advance of the merging taper to direct vehicular traffic to remain within the traveled way.**[2]
10. **The buffer space length The buffer space length shall be as shown in Table 6H-3 on Page 6H-5 for the posted speed limit.**
11. **A truck-mounted attenuator (TMA) shall be used on Limited Access highways and multi-lane roadways with posted speed limit equal to or greater than 45 mph.**
12. **When a side road intersects the highway within the temporary traffic control zone, additional traffic control devices shall be placed as needed.**

1: Revision 1 – 4/1/2015
2: Revision 2 – 9/1/2019

Shoulder Operation with Minor Encroachment
(Figure TTC-5.2)

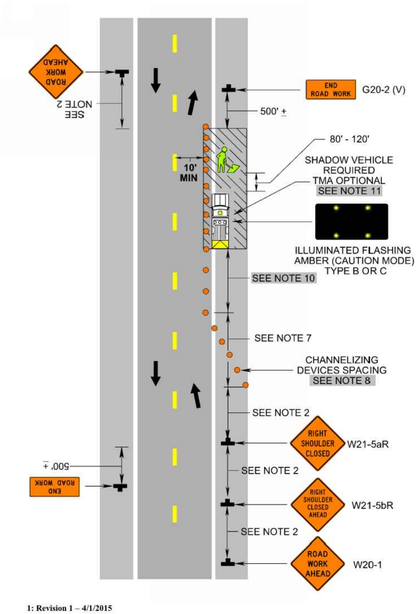

1: Revision 1 – 4/1/2015
2: Revision 2 – 9/1/2019

H:\DV\194600\DATA\VTN\CSP\LXNSFTS\MAJOR SPA\V194600_SHT-S-----AA1V01T C-803 - MOT

BOHLER
SITE CIVIL AND CONSULTING ENGINEERING
LAND SURVEYING
PROGRAM MANAGEMENT
LANDSCAPE ARCHITECTURE
INSTALLATION DESIGN
PERMITTING SERVICES
TRANSPORTATION SERVICES
THE INFORMATION, DESIGN AND CONCEPTS THAT ARE SHOWN ON THIS PLAN ARE TECHNOLOGY AND SHALL NOT BE COPIED OR USED FOR ANY PURPOSE WITHOUT PRIOR WRITTEN AUTHORIZATION FROM BOHLER. ONLY APPROVED AND SEALED PLANS SHALL BE UTILIZED FOR CONSTRUCTION PURPOSES.
© 2020 BOHLER

REVISIONS

REV	DATE	COMMENT	DRAWN BY / CHECKED BY

811 Know what's below. Call before you dig.
ALWAYS CALL 811
It's fast. It's free. It's the law.

NOT APPROVED FOR CONSTRUCTION

THIS DRAWING IS INTENDED FOR MUNICIPAL AND/OR AGENCY REVIEW AND APPROVAL. IT IS NOT INTENDED AS A CONSTRUCTION DOCUMENT UNLESS INDICATED OTHERWISE.

PROJECT No.:	V194600
DRAWN BY:	EEN
CHECKED BY:	RTY
DATE:	03/18/2020
CAD I.D.:	1

PROJECT:

MAJOR SITE PLAN AMENDMENT

FOR

29TH PLACE DRIVE THRU

LOCATION

1500 SEMINOLE TRAIL
CHARLOTTESVILLE, VA 22901
ALBEMARLE COUNTY

BOHLER
28 BLACKWELL PARK LANE, SUITE 201
WARRENTON, VIRGINIA 20186
Phone: (540) 349-4500
Fax: (540) 349-0321
VA@BohlerEng.com

COMMONWEALTH OF VIRGINIA
RYAN YAUGER
Lic. No. 0402056625
6/18/2020
PROFESSIONAL ENGINEER

SHEET TITLE:

MAINTENANCE OF TRAFFIC PLAN

SHEET NUMBER:

C-803

REVISION 1 - 6/18/2020

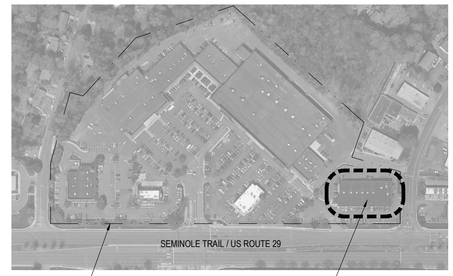

NORTH

E7 CONTEXT

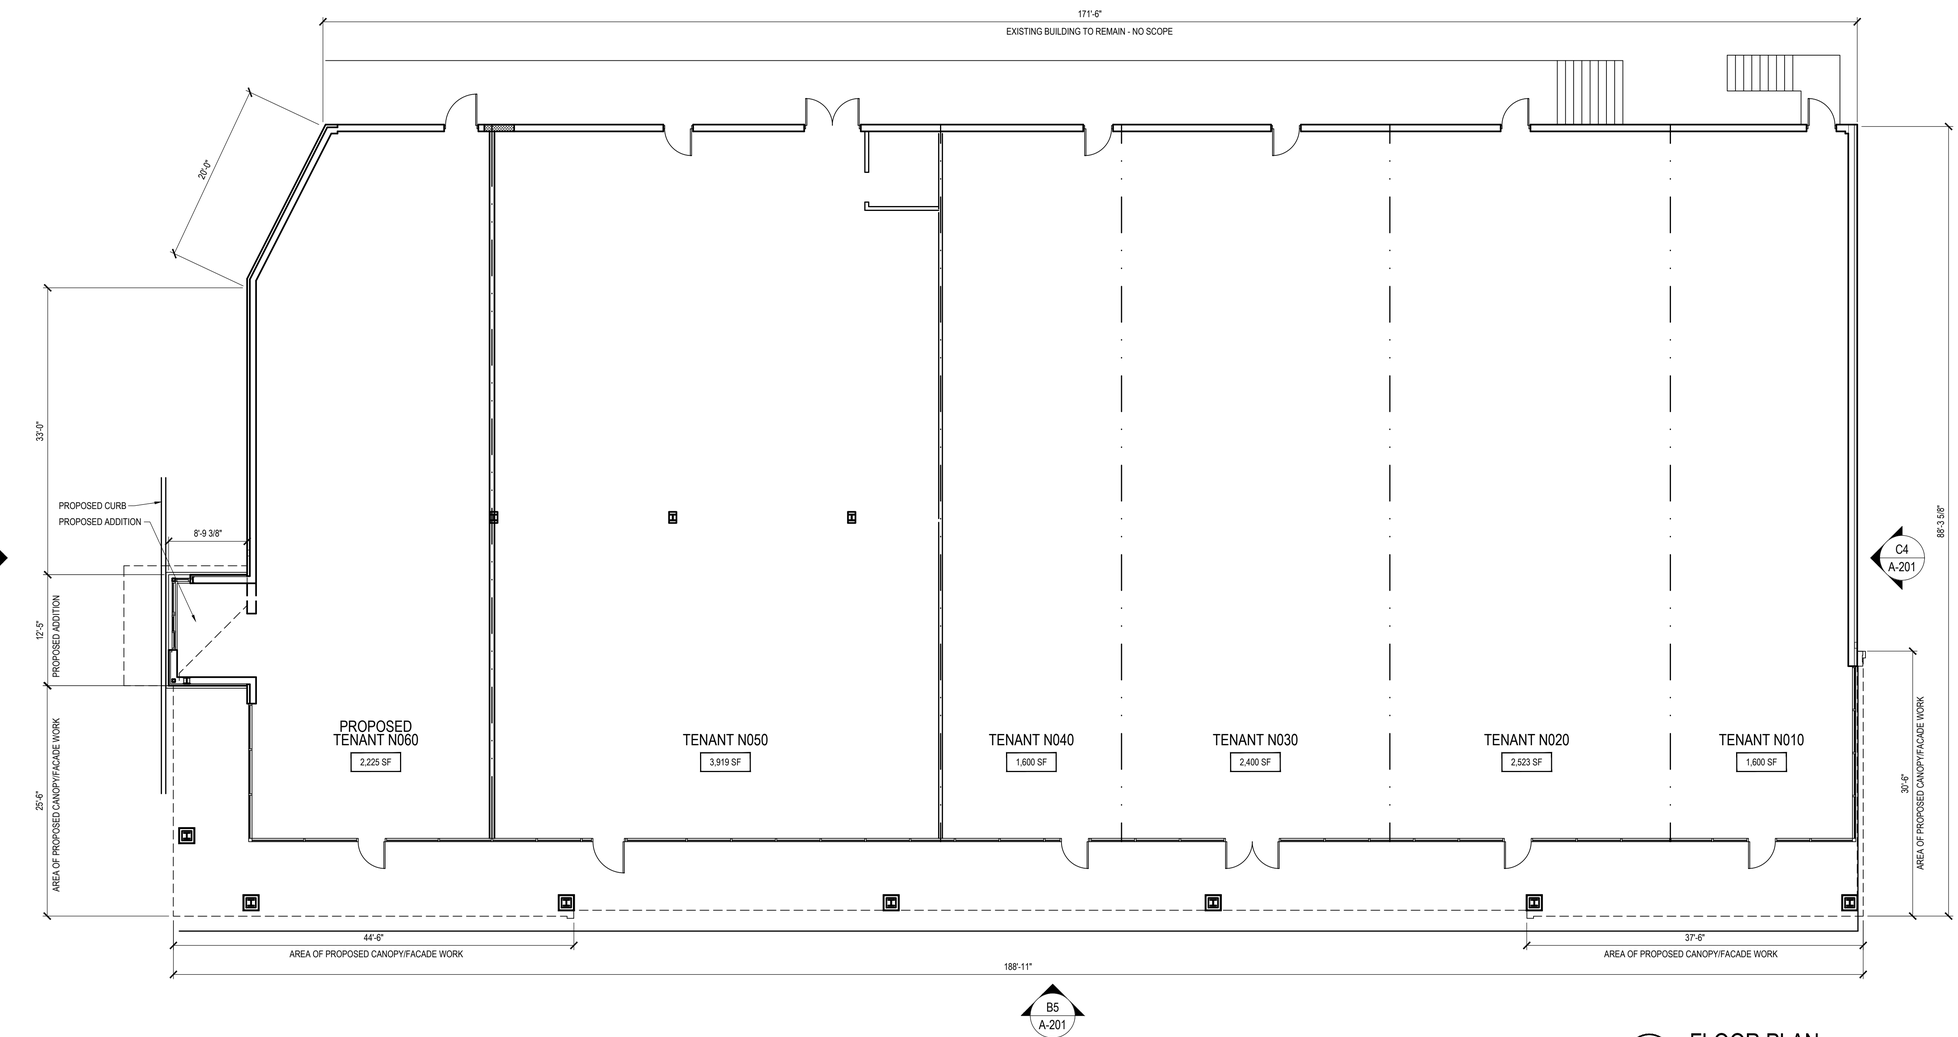

B6 FLOOR PLAN
SCALE: 1/8" = 1'-0"

JP2 ARCHITECTS
2811 Dillon Street
Baltimore, MD 21224
410.646.8300
JP2architects.com

CONSULTANT TEAM

Structural:
Carroll Engineering, Inc.
215 Schilling Circle
Suite 102
Hunt Valley, MD 21031
410.785.7423

Mechanical, Electrical, Plumbing:
Richard J. Stern, P.E.
2741 Furnace Road
Felton, PA 17322
717.891.6026

SEAL / SIGNATURE

PROJECT

Modifications to
BUILDING N
29th PLACE
Charlottesville, VA
22901

CLIENT / OWNER

Federal Realty Investment Trust
1626 East Jefferson Street
Rockville, MD 20852
301.998.8100

REVISION DRAWING LOG

No.	Date	Title

PROJECT NUMBER: 20-027

COPYRIGHT © 2020 JP2 ARCHITECTS

DRAWING TITLE

FLOOR PLAN

DRAWING NUMBER

ARB-A-101

Issue Date 03.16.2020

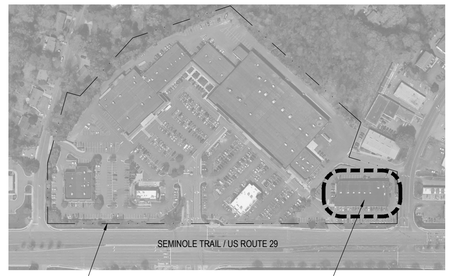

NORTH

E7 CONTEXT

D3 A-201

171'-6"
EXISTING BUILDING TO REMAIN - NO SCOPE

20'-0"

VISIBILITY OF ALL (NEW) MECHANICAL EQUIPMENT FROM THE ENTRANCE CORRIDOR SHALL BE ELIMINATED.

SHOULD THE NEW MECHANICAL UNITS BE VISIBLE FROM THE EC AFTER CONSTRUCTION, THEN THE OWNER WILL PROVIDE FULL MECHANICAL SCREENING IN ACCORDANCE WITH THE GUIDELINES.

01

PROPOSED RTU

PROPOSED RTU

EXISTING RTU

EXISTING RTU

EXISTING RTU

EXISTING RTU

EXISTING RTU

EXISTING RTU

EXISTING RTU

EXISTING RTU

33'-0"

PROPOSED ADDITION

PROPOSED DRIVE-THRU CANOPY

8'-9 3/8"

A6 A-201

12'-5"
PROPOSED ADDITION

25'-6"
AREA OF PROPOSED CANOPY/FACADE WORK

C4 A-201

88'-6 1/8"

30'-6"
AREA OF PROPOSED CANOPY/FACADE WORK

44'-6"
AREA OF PROPOSED CANOPY/FACADE WORK

37'-6"
AREA OF PROPOSED CANOPY/FACADE WORK

188'-6 3/8"

B5 A-201

B4 ROOF PLAN
SCALE: 1/8" = 1'-0"

JP2

JP2 ARCHITECTS
2811 Dillon Street
Baltimore, MD 21224
410.646.8300
JP2architects.com

CONSULTANT TEAM

Structural:
Carroll Engineering, Inc.
215 Schilling Circle
Suite 102
Hunt Valley, MD 21031
410.785.7423

Mechanical, Electrical, Plumbing:
Richard J. Stern, P.E.
2741 Furnace Road
Felton, PA 17322
717.891.6026

SEAL / SIGNATURE

PROJECT

Modifications to BUILDING N 29th PLACE Charlottesville, VA 22901

CLIENT / OWNER

Federal Realty Investment Trust
1626 East Jefferson Street
Rockville, MD 20852
301.998.8100

REVISION DRAWING LOG

No.	Date	Title
01	06.23.2020	REVISIONS per ARB COMMENTS

PROJECT NUMBER: 20-027

COPYRIGHT © 2020 JP2 ARCHITECTS

DRAWING TITLE

ROOF PLAN

DRAWING NUMBER

ARB-A-102

Issue Date 03.16.2020

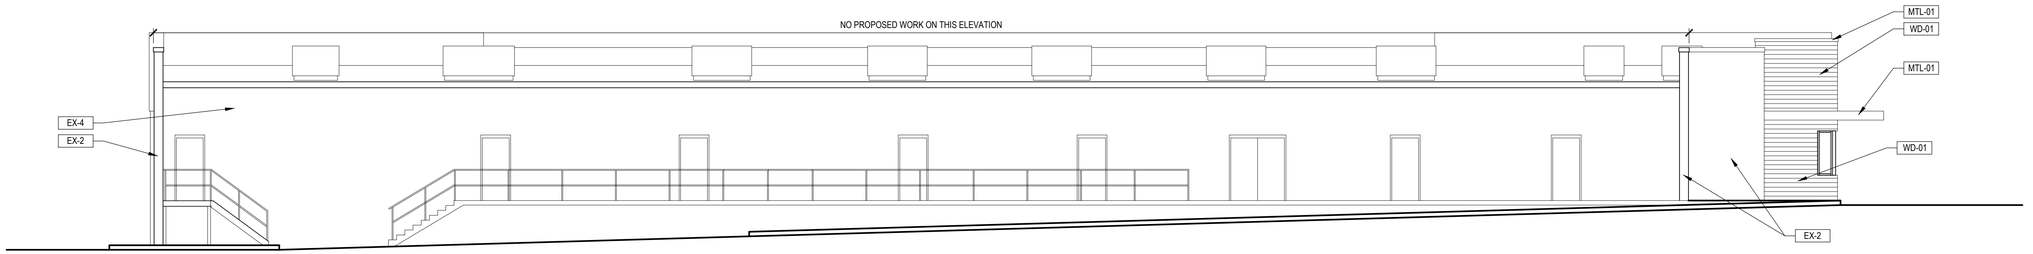

D3 WEST ELEVATION
SCALE: 1/8" = 1'-0"

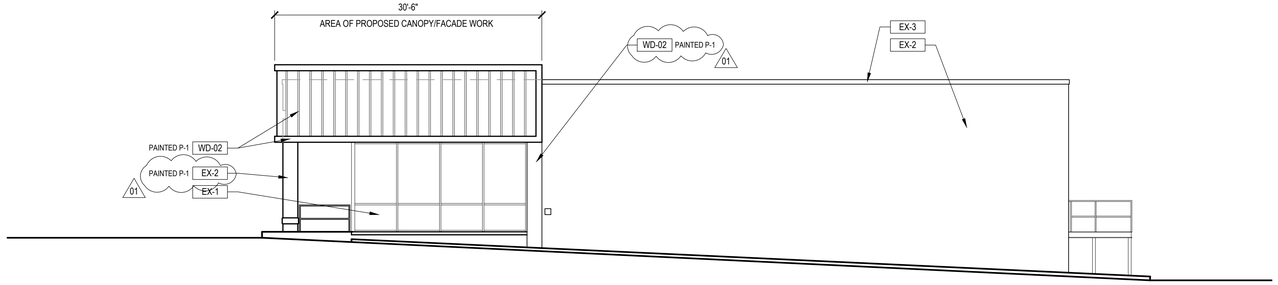

C4 NORTH ELEVATION
SCALE: 1/8" = 1'-0"

VISIBILITY OF ALL [NEW] MECHANICAL EQUIPMENT FROM THE ENTRANCE CORRIDOR SHALL BE ELIMINATED.

SHOULD THE NEW MECHANICAL UNITS BE VISIBLE FROM THE EC AFTER CONSTRUCTION, THEN THE OWNER WILL PROVIDE FULL MECHANICAL SCREENING IN ACCORDANCE WITH THE GUIDELINES.

01

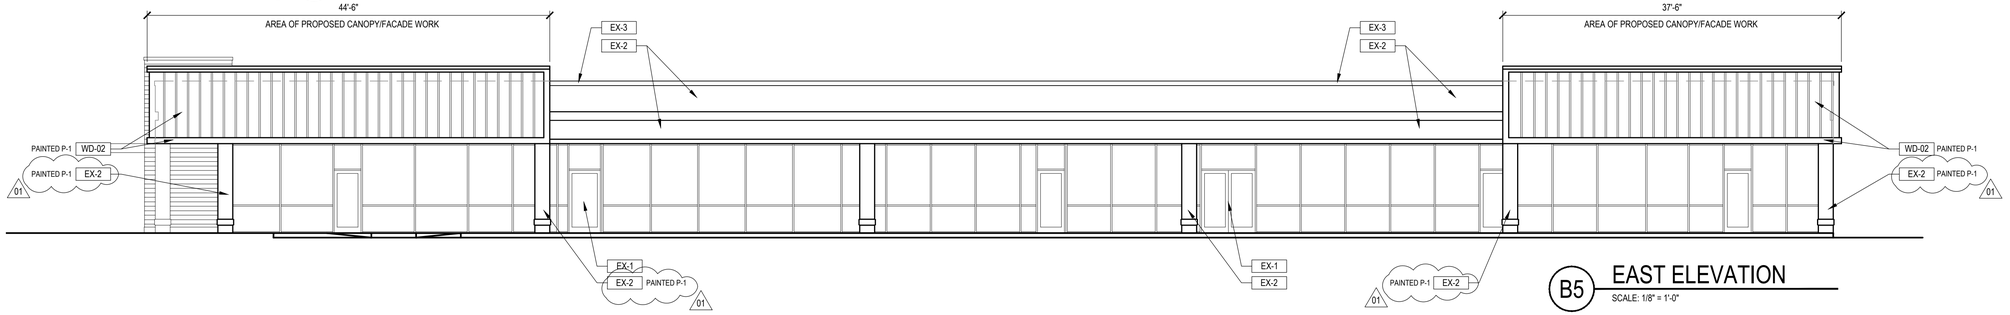

B5 EAST ELEVATION
SCALE: 1/8" = 1'-0"

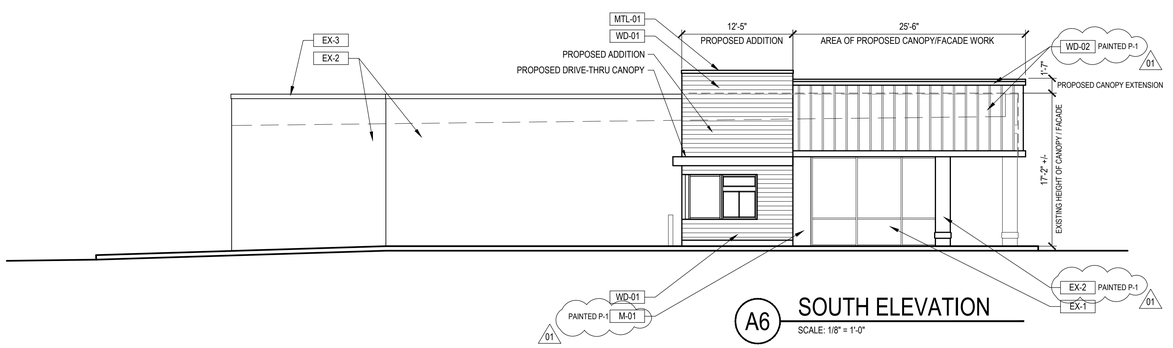

A6 SOUTH ELEVATION
SCALE: 1/8" = 1'-0"

MATERIAL LEGEND

EX-01	EXISTING STOREFRONT AND GLAZING	M-01	BRICK TO MATCH EXISTING	BRICK SIZE and TEXTURE TO MATCH EXISTING — PAINTED P-1
EX-02	EXISTING BRICK	MTL-01	METAL	ATAS INTERNATIONAL — COLOR: CHARCOAL GRAY
EX-03	EXISTING METAL COPING	WD-01	HORIZONTAL WOOD SIDING	reSAWN TIMBER CO. — ACCOYA WOOD SIDING, COLOR: GOBI-SHOU SUGI BAN
EX-04	EXISTING CMU	WD-02	PREFINISHED ENGINEERED WOOD BOARD and TRIM	LP BUILDING SOLUTIONS - CEDAR TEXTURE — COLOR: PRIMED, PAINTED P-1
		P-1	SHERWIN-WILLIAMS HISTORIC COLLECTION SW2848 "ROYCROFT PEWTER"	

JP2 ARCHITECTS
2811 Dillon Street
Baltimore, MD 21224
410.646.8300
JP2architects.com

CONSULTANT TEAM

Structural:
Carroll Engineering, Inc.
215 Schilling Circle
Suite 102
Hunt Valley, MD 21031
410.785.7423

Mechanical, Electrical, Plumbing:
Richard J. Stern, P.E.
2741 Furnace Road
Felton, PA 17322
717.891.6026

SEAL / SIGNATURE

PROJECT

Modifications to BUILDING N 29th PLACE Charlottesville, VA 22901

CLIENT / OWNER

Federal Realty Investment Trust
1626 East Jefferson Street
Rockville, MD 20852
301.998.8100

REVISION DRAWING LOG

No.	Date	Title
01	06.23.2020	REVISIONS per ARB COMMENTS

PROJECT NUMBER: 20-027

COPYRIGHT © 2020 JP2 ARCHITECTS

DRAWING TITLE

ELEVATIONS

DRAWING NUMBER

ARB-A-201

Issue Date 03.16.2020

ARB Review Comments dated June 2, 2020:

Ref #1

Revise the renovation design to incorporate architectural details, forms and colors that establish a cohesive appearance for the existing building and compatibility with the surrounding site. Consider the form and material for clear column support for the existing brick and the proposed siding elements. Consider a lighter alternative color for the siding.

Applicant Response:

The renovation design has been revised to adjust the existing columns immediately under the proposed siding areas. These existing columns will be painted to match the siding above. The siding color has been lightened to more closely align with the roof color of the main building at 29th Place.

existing conditions

east facade - original proposal 06.01.2020

east facade - current proposal

JP2 Architects, LLC
2811 Dillon Street
Baltimore, MD 21224

revision 01 - response to ARB comments
proposed elevations - building N
27 July 2020

29th Place
Charlottesville, VA

Federal Realty Investment Trust
1626 E. Jefferson S treet
Rockville, MD 20852

EXISTING CONDITIONS

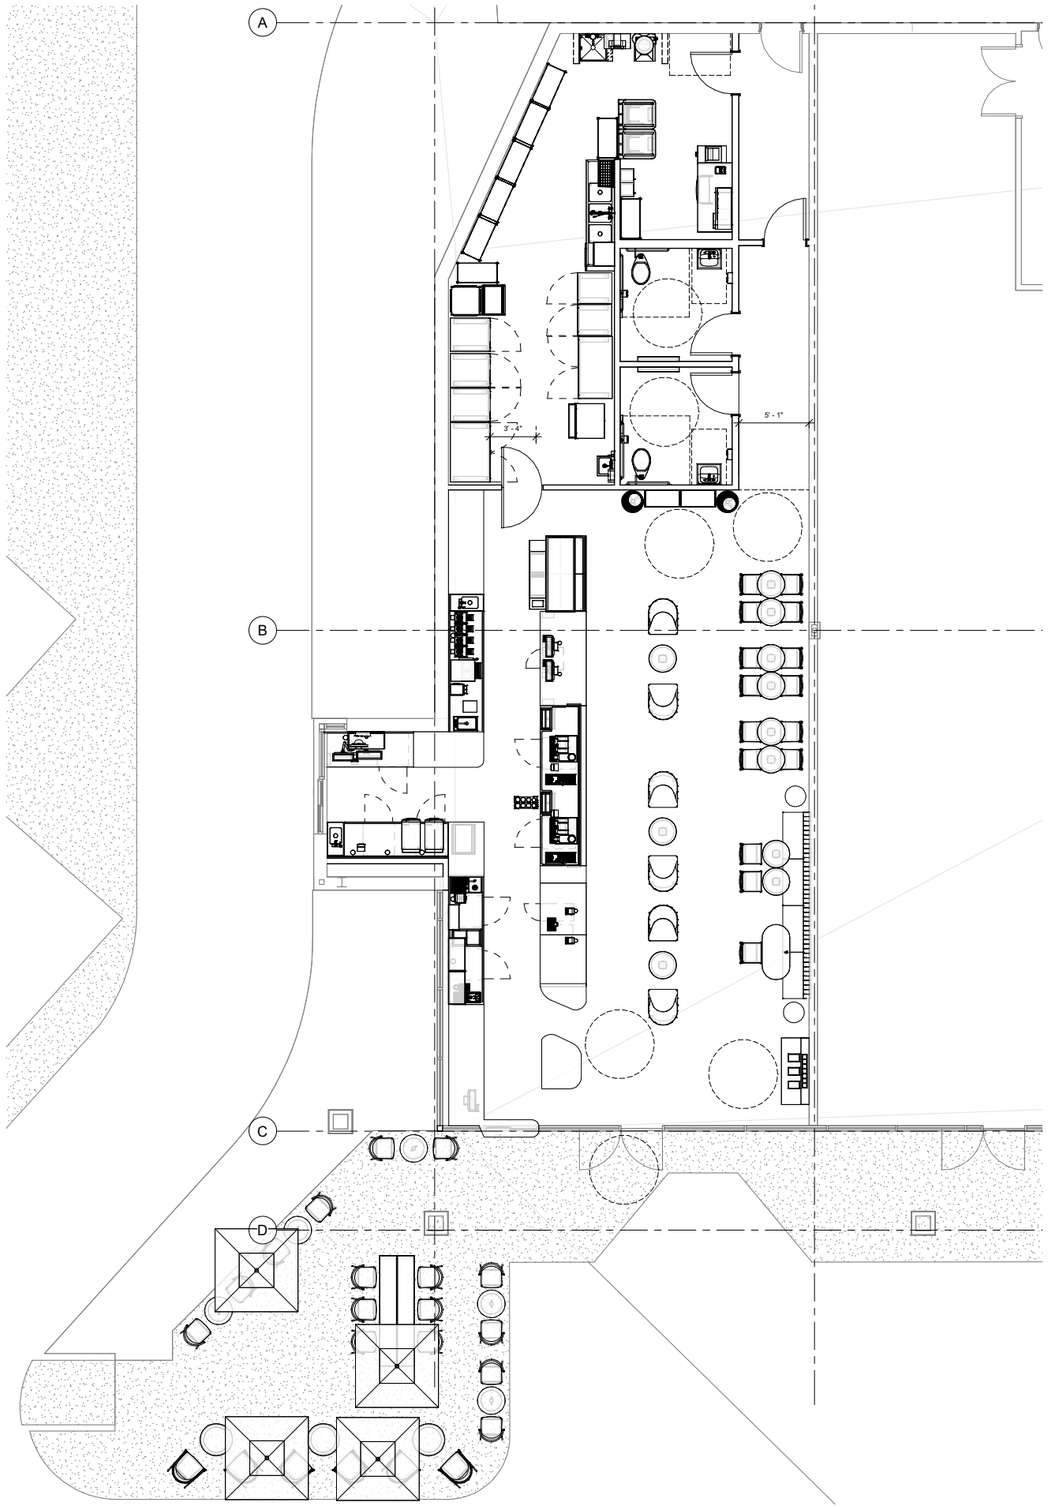
A
B
C
D
3' - 4"
5' - 1"

EXISTING OVERALL PLAN

29TH PLACE | Charlottesville, VA
Federal Realty Investment Trust

STUDIO39

12024 | 24 JUNE 2020

PROPOSED OVERALL PLAN

29TH PLACE | Charlottesville, VA
Federal Realty Investment Trust

STUDIO39

12024 | 24 JUNE 2020

Proposed 4′ crosswalk
Proposed 4′ sidewalk
Trash enclosure
Clearance bar
DRIVE THRU
STOP
Landscaped area buffers drive through
Proposed pre-order board
Proposed Canopy
Proposed Menu Board
Proposed 1500 gallon Grease trap
Proposed 4′ sidewalk
Proposed pick up window
Bike Rack
SPACE NO60 **with DriveThru** 2,240 +/- S.F.
SPACE NO50 DOWNSIZE - WHITE BOX 3,919 S.F.
SPACE NO40 WILD BIRDS UNLIMITED
SPACE NO30 MUSIC AND ARTS CENTER
SPACE NO20 T-MOBILE
SPACE NO10 WHITE BOX 1,673 S.F.
Restriped ADA crosswalk path
STOP
Landscaped island
250 SF Railing enclosed Dining area
SCALE 1″ = 20′-0″
0 10 20 40

ENLARGED PROPOSED PLAN

29TH PLACE | Charlottesville, VA
Federal Realty Investment Trust

STUDIO39

12024 | 24 JUNE 2020

PROPOSED OVERALL PLAN WITH EXISTING OVERLAY (RED)

29TH PLACE | Charlottesville, VA
Federal Realty Investment Trust

STUDIO39

12024 | 24 JUNE 2020